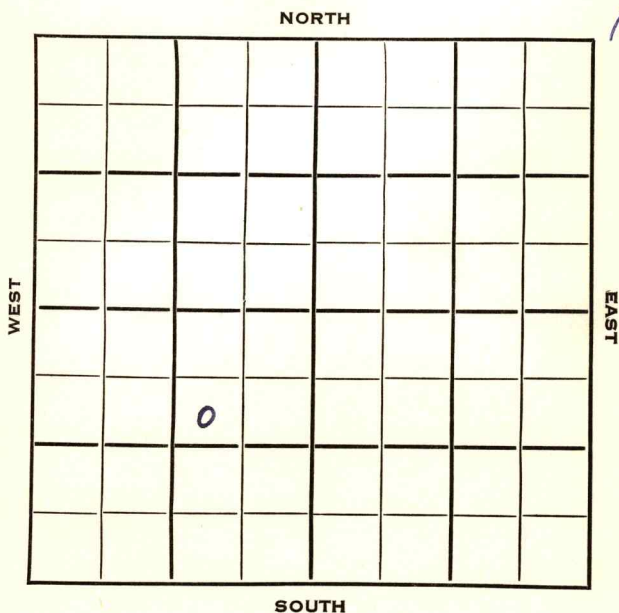


Section 24 Township 33 Range 14WWell No. 1 LenkerCompany *B-M-R*
Gramhart & Miller & Lion Oil

O.W.W.O.

Barber

KANSAS

SEC.	TWP.	R.
24	33	14 W ✓

WELL NO.

1 Lenker

FARM

COMPANY

G-M-R

~~Gramhart & Miller & Lion Oil~~

CONTRACTOR

~~MM~~ G-M-R

Wildcat


990 Ft. from N. Line

Ft. from S. Line

990 Ft. from E. Line

Ft. from W. Line

SW NE SW

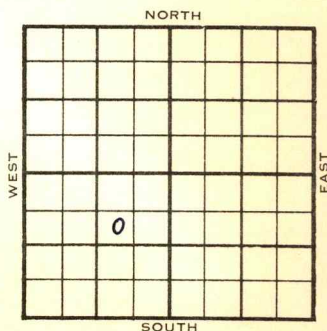

	ELEVATION	REPORT
1954	1853'	
3/3	Spud 3-1-54 Rng. surface	
3/10	8" @ 230' w/200 sks S.D. 3580'	
3/17	Elgin 3909' DST 3879'-3928' 1 hr, 150' M 1260# Doug 4070' DST 4053'-90' 1 hr, 290' Wtr 1310# Lans 4206' Drlg 4267'	
3/24	DST 4684'-4701' 1 hr, 3360' gas, 70' socm, 70' o & gcm 380# Miss 4759' DST 4756'-73' 1 hr, 62' gcm, 1800# DST 4775'-4800' 1 hr, 1,790,000 gas in 2", 1760# DST 4801'-30' 1 hr, 30' M 0# Drlg 4875'	
3/31	Kh. 4996', Chat 5010', V 5061' DST 5062'-80' 1 hr, 15' M 0# Simp 5186' Drlg 5292'	
4/7	Arb 5315' RTD 5355' Schl 5" @ 5160'	

OVER

1954

4/21

Spud 3-1-54

Gas Well

TD 5355'

8" @ 230'

Elgin 3909'

DST 3879'-3928' opn 1 hr, rec 150' Mud
1260# **Doug 4070'**

DST 4053'-90' opn 1 hr, rec 290' wtr.
1310# **Lans 4206'**,

DST 4684'-4701' opn 1 hr, rec 3360' ga
70' socm, 60' o & gcm 380#

Miss 4759'

DST 4756'-73' opn 1 hr, rec 62' gcm
1800#

DST 4775'-4800' opn 1 hr, ~~rec~~ .
1,790,000 gas in 2 min 1760#

DST 4801'-30' opn 1 hr, rec 30' Mud
0# **Kh. 4996', Chert 5010', Viola
5061'**

DST 5062'-80' opn 1 hr, rec 15' Mud
0# **Simp 5186', Arb 5315'**

TD 5355'

5" @ 5160'

CO to 5143'

18/ 5116/22 S/ 4 bwph

2 hr. PB 5110'

18/ 5082'-88' S/ 2 bwph

2 hr.

PB 4865'

24/ 4813-21 18/ 4821'-27'

1000 A 4,500,000 cfg 4000 A

Comp 8,000,000 cfgpd.

COMPLETED

1956

O.W.W.O.

1-11

OTD 5354

5" @ 5160 , **Elgin 3909, H. 4002**

CO SP 4808 112/ 4772-4800, frac

CO SP 4808 frac, 7,340 mcfg

Comp. , **Dg. 4006, L. 4204, M. 4750**

K. 4998, Chatta 5010, V. 5070

S. 5199, A 5320,

TD 5354'

FIRST REPORT

✓

COMPLETED

County **Barber** State **Kansas**Sec. **24** (Blk. Twp.) **33** (Sur. Rge.) **14W** Map No.Operator **Gramhart & Miller & Lion Oil**Well No. **1** Farm **Lenker**Elev. Location **SW NE SW**990 Ft. From **N** Line **SW**990 Ft. From **E** Line Quarter1st. Report **MAR 3 1954**

Completion

Remarks

G-M-R - Contr.Spudding Date **3-1-54**Drilg. Data **Wildcat****rng. surface**

J. G. McGEHEE

County Barber State Kansas
 Sec. 24 (Blk.) 33 (Sur.) 14W Map No.
 Operator Gramhart & Miller & Lion Oil
 Well No. 1 Farm Lenker
 Elev. 1853 Location SW NE SW



990 Ft. From N Line SW
990 Ft. From E Line Quarter

1st. Report

Completion APR 21 1954

Remarks Wildcat

G-M-R - Contr.

Spudding Date 3-1-54

Drlg. Data Gas well TD 5355

8" @ 230 Elgin 3909 DST 3879-3928

open 1 hr. Rec. 150' mud 1260#

Doug. 4070 DST 4053-90 open 1 hr.

Rec. 290' wtr. 1310# Lans. 4206

DST 4684-4701 open 1 hr. Rec. 3360' gas

70' soem 60' o & gcm 380# Miss. 4759

DST 4756-73 open 1 hr. Rec. 62' gcm

1800# DST 4775-4800 open 1 hr.

1,790,000 gas in 2 min. 1760#

DST 4801-30 open 1 hr. Rec. 30' mud

O# Kh. 4996 Chert 5010 Viola 5061

DST 5062-80 open 1 hr. Rec. 15' mud O#

Simp. 5186 Arb. 5315 TD 5355 5" @ 5160

CO to 5143 18/ 5116-22 S/ 4 bwph

J. G. McGEHEE

Drig. Data

2 hr. PB 5110 18/ 5082-88 S/ 2 bwph
2 hr. PB 4865 24/ 4818-21 18/ 4821-27
1000 A 4,000,000 cfig 4000 A
Comp. 8,000,000 cfigpd

APR 27 1954

Scout Cards

Land Scout Map

Land Well Map

4818-21

4821-27

5082-88

U.W.W.O.

FORM 513 REV. SUNRAY

OWWO

County Barber Elev. 1853

Sec. 24 Twp. 33 Rge. 14W

Company G.M.R.

Farm Name Lenkner No. 1

TOPS	DEPTH	LOG	DATUM	Loc. in Sec.
Anh.				
Tp. <u>Elgin</u>	<u>3909</u>			<u>SW NE SW</u>
H.	<u>4002</u>			
Tr.				
Dg.	<u>4006</u>			
Bl.				
L.	<u>4204</u>			
K.C.				Geol. _____
B.K.C.				Contr. _____
Ce.				
C.				
M.	<u>4750</u>			
M.				Pool _____
K.	<u>4998</u>			
Mz.				<u>Medicine Lodge</u>
Ma. <u>Chatter</u>	<u>5010</u>			
V.	<u>5070</u>			
S.	<u>5199</u>			
S.				
A.	<u>5320</u>			
R.				
Pe.				
G.				
T.D.	<u>5354</u>			

JAN 11 '56

FIRST REPORT

o

COMPLETE

Date Comm.

OTD 5354 5" @ 5160 CO SP 4808

112/4772-4800 frac CO SP 4808

frac 7,340 mcfg Comp.

AC