


Barber

KANSAS

SECTION 24 TOWNSHIP 33 RANGE 11 W

WELL NO. #2 Lenkner

COMPANY G-M-R Lion Oil

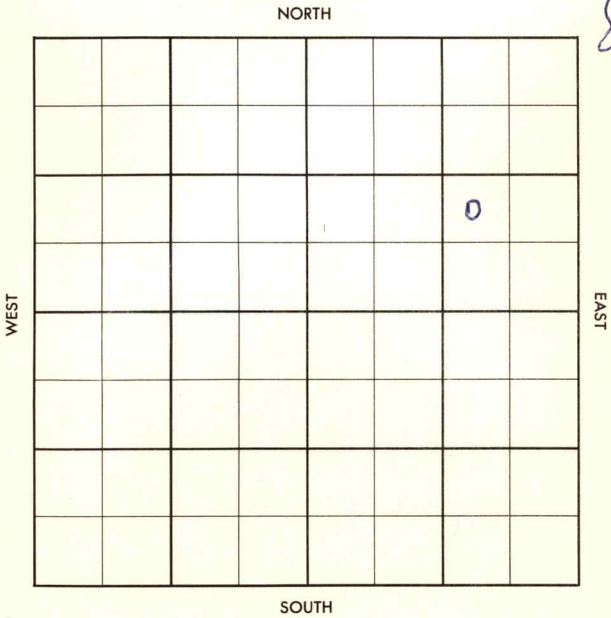

Barber

KANSAS

SEC.	TWP.	R.
24	33	14W

WELL NO. #2 Lenkaer FARM

COMPANY G-M-R & Lion Oil


CONTRACTOR Co Tools  
Medicine Lodge

\_\_\_\_\_ Ft. from N. Line

\_\_\_\_\_ Ft. from S. Line

\_\_\_\_\_ Ft. from E. Line

\_\_\_\_\_ Ft. from W. Line

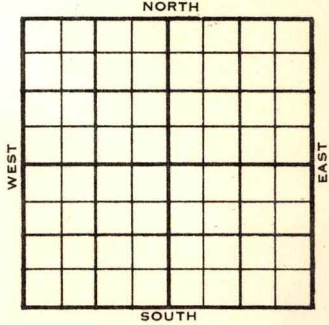

NW SE NE

1955	ELEVATION 1831'	REPORT
11/16	Loc	
<u>1956</u>		
1-5	Comm. 11-17-55 8 5/8" @ 280/180 DST 4647-75 gas to surface in 7 min. ga. 62 mcfg op 1 hr. rec. 1400' oil & muddy oil, 950/30" 5 1/2" @ 4750/100 CO 24/ 4656-62 gas to surface <del>immediately</del> immediately FU 400' oil, 30 min., 1250 A, S/ 4 1/2 boph Comp. 213 <del>bopd</del> bopd LeComp 3751 Elg. 3788 Heeb. 3969 Tor. 3986 Doug. 4009 L. 4147 Marm 4623 M. 4697 TD 4750'	
		ABANDONED
		COMPLETED

County **Barber** Elev. \_\_\_\_\_  
 Sec. **24** Twp. **33** Rge. **14W**  
 Company **G-M-R & Lion Oil**  
 Farm Name **Lenkner** No. **2**


Co.

TOPS	DEPTH	LOG	DATUM
Anh.			
TP.			
H.			
Tr.			
Dg.			
Bl.			
L.			
K.C.			
B.K.C.			
Ce.			
C.			
M.			
M.			
K.			
Mz.			
Me.			
V.			
S.			
S.			
A.			
R.			
PE.			
G.			
T.D.			

Loc. in Sec. **NW SE NE**

Geol. \_\_\_\_\_  
Contr. **Co. tools**

Pool **Medicine Lodge**

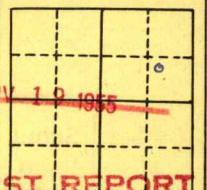

**FIRST REPORT**

Date Comm. **NOV 16 1955**  
**M I R**

Lse.

No.

Sec.

T.

R.



County Barber Elev. 1831  
 Sec. 24 Twp. 33 Rge. 14W  
 Company G-M-R & Lion Oil  
 Farm Name Lenkner No. 2

TOPS	DEPTH	LOG	DATUM
Anh.			
Tp. <u>Lo Comp</u>	<u>3751</u>		<u>1920</u>
H. <u>E19</u>	<u>3788</u>		<u>1957</u>
Tr. <u>Hyde</u>	<u>3969</u>		<u>2138</u>
Dg. <u>Jarv.</u>	<u>3986</u>		<u>2155</u>
Bl. <u>Doug</u>	<u>4009</u>		<u>2178</u>
L. <u></u>	<u>4147</u>		<u>2316</u>
K.C. <u>Mash</u>	<u>4623</u>		<u>2792</u>
B.K.C.			
Ce.			
C.			
M.	<u>4697</u>		<u>2866</u>
M.			
K.			
Mz.			
Mq.			
V.			
S.			
S.			
A.			
R.			
Pe.			
G.			
T.D.	<u>4750</u>		

Loc. in Sec. NW SE NE  
 Geol. \_\_\_\_\_  
 Contr. \_\_\_\_\_  
 Co. tools \_\_\_\_\_  
 Pool \_\_\_\_\_  
 Medicine Lodge \_\_\_\_\_



Date Comm. 11-17-55 JAN 5 1956  
8 5/8" @ 280/180 DST 4647-75 gas to  
surface in 7 min. ga. 62 mcfg open 1 hr  
rec. 1400' oil & muddy oil 950/30"  
5 1/2" @ 4750/100 CO 24/ 4656-62  
gas to surface immediately FU 400' oil  
30 min. 1250 A S/ 4 1/2 boph  
Comp. 213 bopd

Co.  
 Use.  
 No.  
 Sec.  
 T.  
 R.