


Section 25 Township 33 Range 11W
Well No. 1 Lenkner "C"
Company Lion Oil & G-M-R

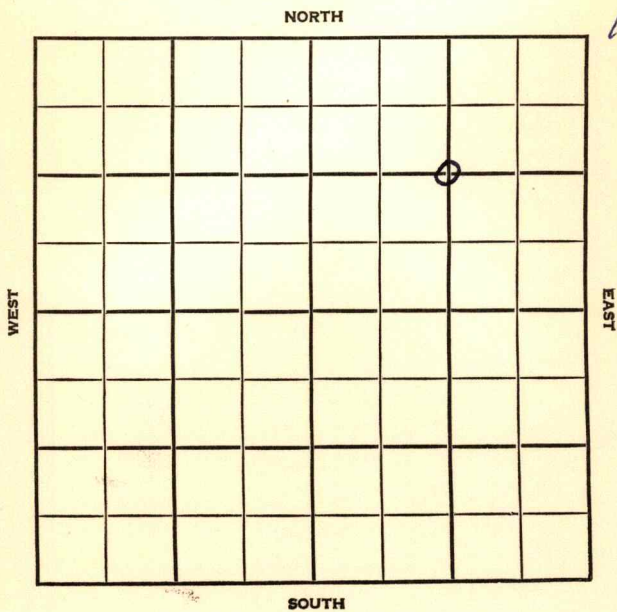

Barber

KANSAS

SEC.	TWP.	R.
25	33	14W

WELL NO.

#1 Lenkner "C"

FARM

COMPANY

Lion Oil & G-M-R

CONTRACTOR

Medicine Lodge Pool


1320 Ft. from N. Line

Ft. from S. Line

1320 Ft. from E. Line

Ft. from W. Line

C NE/4

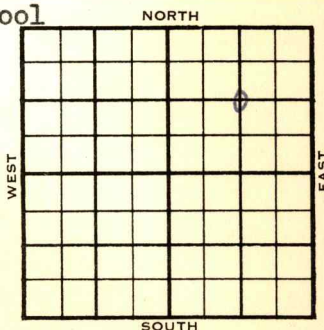

1955

ELEVATION

1851

REPORT

4/20

Spud 4-16-55

8" @ 264'

Drlg. 2387'

6/8

Comm 4-16-55

H 4031

Dg 4068

Doug sd 4078

L 4213

M 4754

TH 8" @ 264/170

DST 4689-4725 open 1 hr Rec 10' mud

0/20" DST 4753-88, open 1 hr gas to surface in 29 min Rec 85' hocm

1400/20" 5 1/2" @ 4852 /80

perf 4780/87 S/10 gf 1/2 go 500 a

S/8 gw 12 goph sq re perf 36/4765-

71 64/4802-18 S/2 1/2 bfph 95% wtr.

D & A

ABANDONED

County Barber Elev. 1851Sec. 25 Twp. 33 Rge. 14WCompany Lion Oil & G-M-RFarm Name Lenkner "C" No. 1

TOPS	DEPTH	LOG	DATUM
Anh.			
Tr.			
H.	<u>4031</u>		<u>2180</u>
Tr.			
Dg.	<u>4068</u>		<u>2217</u>
<u>Bl. Doug sd</u>	<u>4078</u>		<u>2227</u>
L.	<u>4213</u>		<u>2362</u>
K.C.			
B.K.C.			
Ce.			
C.			
M.	<u>4754</u>		<u>2903</u>
M.			
K.			
Mz.			
Ma.			
V.			
S.			
S.			
A.			
R.			
Pf.			
G.			
T.D.			

Loc. in Sec. _____

C NE/4

Geol. _____

Contr. _____

Pool _____

Medicine Lodge _____

Date Comm. 4-16-55JUN 8 19558" @ 264/170 DST 4689-4725 open 1 hr.Rec. 10' mud 0/20" DST 4753-88open 1 hr. gas to surface in 29 min.Rec. 85' hocm 1400/20" 5 1/2" @ 4852/80perf/ 4780-87 S/ 10 gf 1/2 go 500 AS/ 8 gw 12 goph sq. reperf/ 36-4765-71 64/ 4802-18 S/ 2 1/2 bfph 95% wtr.D & A

County Barber State KansasSec. 25 (Blk.) 33 (Sur.) 14W Map No.Operator Lion Oil & G-M-RWell No. 1 Farm Lenkner "C"Elev. Location C NE/4

FIRST REPORT

1320 Ft. From N Line NE1320 Ft. From E Line Quarter1st. Report APR 20 1955

Completion

Remarks

Spudding Date 4-16-55Medicine Lodge Pool

Drlg. Data

8" @ 264 drlg. 2387

FABEN GILSTRAP