


Barber

KANSAS

SECTION 17 TOWNSHIP 33S RANGE 14W


WELL NO. #1 McGrath

COMPANY Petroleum Inc.

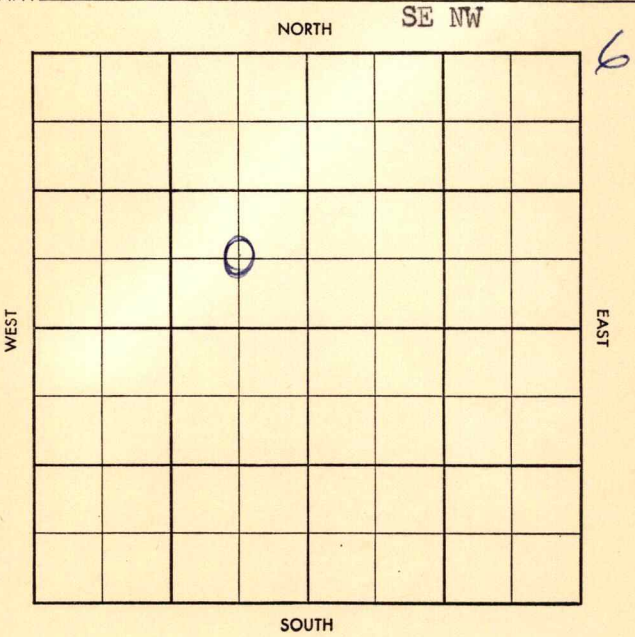

County Barber Elev. 1795 DF
 Sec. 17 Twp. 33 Rge. 14W
 Company Petroleum Inc.
 Farm Name McGrath No. 1

TOPS	DEPTH	LOG	DATUM	Loc. in Sec.
Anh. <u>E 191.1</u>	<u>3797</u>			<u>SE NW</u>
Tr.				
H.	<u>3952</u>	<u>3954</u>		<u>2030' fnl x</u>
Tr.				
Dg.	<u>3989</u>	<u>3991</u>		<u>2005' fwl NW</u>
B.L. <u>D 952</u>	<u>4018</u>	<u>4026</u>		
L.	<u>4164</u>	<u>4160</u>		
K.C.				Geol.
B.K.C.	<u>4581</u>	<u>4596</u>		
Ce.	<u>4730</u>			Contr.
C.				<u>Garvey #22</u>
M. <u>chart</u>	<u>4749</u>	<u>4750</u>		Pool
M. <u>LI</u>	<u>4768</u>	<u>4770</u>		<u>Wildcat</u>
K.				
Mz.				
Mq.				
V.				
S.				
S.				
A.				
R.				
Pf.				
G.				
T.D.	<u>4850</u>	<u>4854</u>		

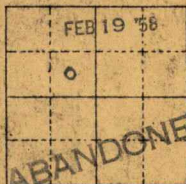

Date Comm. 1/31/58 (Shell - AC & DHM)
8" @ 1095 w/350, Drlg. 2330. FEB 12 '58 3710
4500 FEB 19 '58 PST 4695-4742 60"
25" AB BHP 100/20 DST 4752
-65 60" 800 gpm 35' gcm
90' 0 gcm 30' SW BHP
1160/20 PST 4750-4850 120" 165
gcm 60' W BHP 500/20 Log

DTA

