Barber KANSAS

SECTION 22 TOWNSHIP 33S RANGE 14W

WELL NO. #1 Harbaugh

COMPANY Sunray Mid-Continent Oil

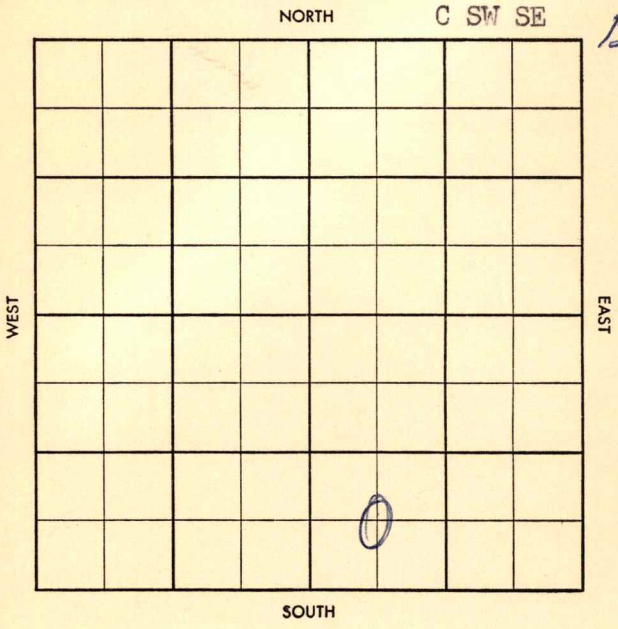

FORM 504-3 SUNRAY

HOT FILE

Barber KANSAS

SEC.	TWP.	R.
22	33 S	14 W

WELL NO. # 1 U. B. Harbaugh FARM

COMPANY Sunray Mid-Continent (DEVELOPMENT)

CONTRACTOR Stickel Drlg.

W Medicine Lodge Field.

_____ FT. FROM N. LINE

660 FT. FROM S. LINE

_____ FT. FROM E. LINE

660 FT. FROM W. LINE

of SE/4
C SW SE

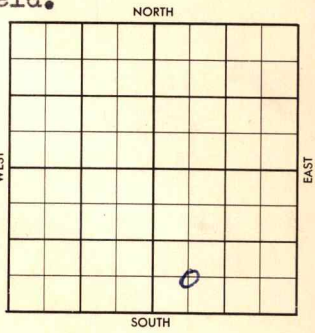

1957	ELEVATION REPORT
	4700' Miss. Test
10/8	MIRT (FR Tkt) (DR#196)
10/9	RURT
10/10	Spudded 10-9-57 13-3/8" @ 224' TD 225' WOC
10/11	Drlg. 750'
10/14	Drlg. 1400'
10/15	Drlg. 1990'
10/16	Drlg. 2350'
10/17	Drlg. 2555'
10/18	Drlg. 2913'
10/21	Drlg. 4190'
10/22	Drlg. 4250'
10/23	Drlg. 4275'
10/24	Drlg. 4430'
10/25	Drlg. 4532'
10/28	TD 4747'. WOC. 5½" @4678'
10/29	TD 4747'. WOC. 5½" csg.
10/30	TD 4747'. WOC. 5½" csg.
10/31	TD 4747'. Bailing.
11/1	TD 4747'. Prep to acidize
11/4	TD 4747'. Swabbing load oil

OVER

1957
11/5 TD 4747'. 3300 MCF Gas
Open hole 4678-4747' Miss. Zone
Complete (DR#216)

S-513-A

CO. Barber ELEV.

SEC. 22 TWP. 33 RGE. 14W

COMPANY Sunray Mid-Cont. 1

FARM Harbaugh

LOC. C SW SE

FIRST REPORT
OCT 9 '57

GEOL.

CONTR. Stickle

POOL W. Medicine Lodge

SPUD
M I R

CO. LSE. NO. SEC. TWP. RGE.

26

S-513-A

CO. Barber ELEV. 1743 DF

SEC. 22 TWP. 33 RGE. 14W

Sunray Mid-Cont. NO. 1

COMPLETE
DEC 11 '57

FARM Harbaugh

LOC. C SW SE

GEOL.

CONTR. Stickle

POOL W. Medicine Lodge

SPUD 10-10-57

M I R 13 3/8"

224/250 8 5/8

1028/1000 ⌀ 1990

OCT 23 '57 ⌀ 4150

OCT 30 '57 Hb 3936

BrLime 4126

Lsg 4134 M 4676 RTD 4747

5 1/2" 4678 woc NOV 6 '57 CO

4747 TD test 500 MCF (1/2)

frac 20x20 tested 3.300

MCF chk TP700 CP920

NOV 13 '57 X wo surface EQUipment

NOV 20 '57 X Production Dept

completed for 3.300 MCF

ck. SIP

CO. LSE. NO. SEC. TWP. RGE.