
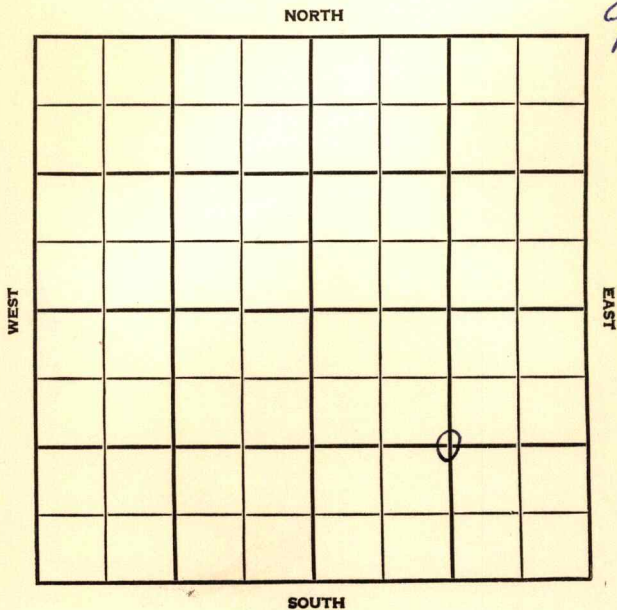


Section 24 Township 33 Range 14 WWell No. # 1 Lenkner "A"Company Gramehart-Miller & Lion

SEC.	TWP.	R.
24	33	14W
WELL NO.		
1 Lenkner "A"		FARM
COMPANY		
Gramehart-Miller & Lion		
CONTRACTOR		
G-M-R		

_____ Ft. from N. Line
 1320 _____ Ft. from S. Line
 1320 _____ Ft. from E. Line
 _____ Ft. from W. Line

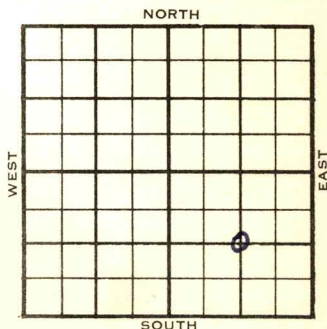

C SE/4

ELEVATION

REPORT

1954

1837'

11/23

Spud 11-18-54
 8" @ 280'
 Drilg. 2600'

1955
2/16

Spud 11-18-54 Oil well TD 4909
 8" @ 280 Heeb 3998 Lans 4178
 Miss 4714

DST 4717-64 open 1 hr rec 50' mud 240#

DST 4765-80 open 1 hr rec 75' mud 0#

TD 4909' 5" @ 4852

Schl tops: Miss 4720, Kh. 4860'

TD 4907 S/15 GOPH 1 BAW SP 4778

24/4759-65 2000 A 1/2 BO 1/2 BAWPH

SP 4750 15/4737-42 38 GOPH

sd-frac CO to 4744 10/4737-42

sd-oil-frac. SP 4730 8/4723-25

1 BOPH 50,000 CFG 15 GOPH SP 4674

16/4666-74 5 BOPH 500,000 CFG

5 hr. 1000 A S/16 BOPH P/4 BOPH

Comp. 100 BOPD 2% wtr.

COMPLETED

County **Barber** State **Kansas**Sec. **24** (Blk.) **33** (Sur.) **14W** Map No.Operator **Grahamhart-Miller & Lion**Well No. **1** Farm **Lenkner "A"**Elev. Location **C SE/4****1320** Ft. From **S** Line **SE****1320** Ft. From **E** Line Quarter1st. Report **NOV 23 1954**

Completion

Remarks

G-M-R - Contr.Spudding Date **11-18-54**

Drlg. Data

8" @ 280 drlg. 2600

FABEN GILSTRAP

County Barber State Kansas
 Sec. 24 (Blk. 33 (Sur. 14W Map No.
 (Twp.) (Rge.)
 Operator Gramehart-Miller & Lion
 Well No. 1 Farm Lenkner "A"
 Elev. 1837 Location C SE/4



1320 Ft. From S Line SE
1320 Ft. From E Line Quarter

1st. Report

Completion FEB 16 1955

Remarks

G-M-R - Contr.

Spudding Date 11-18-54

Drlg. Data Oil well TD 4909

8" @ 280 Heeb. 3998 Lans. 4178

Miss. 4714 DST 4717-64 open 1 hr.

Rec. 50' mud 240# DST 4765-80

open 1 hr. Rec. 75' mud 0# TD 4909

5" @ 4852 SCHLUMBERGER TOPS:

Miss. 4720 Kh. 4860 TD 4907

CO to 4827 36/ 4786-98 3000 A

S/ 15 goph 1 baw SP 4778 24/ 4759-65

2000 A $\frac{1}{2}$ bo $\frac{1}{2}$ bawph SP 4750

15/ 4737-42 38 goph $\frac{sd}{frac}$ CO to 4744

10/ 4737-42 sd-oil-frac SP 4730

8/ 4723-25 1 boph 50,000 cfg 15 goph

SP 4674 16/ 4666-74 5 boph 500,000 cfg

5 hr. 1000 A S/ 16 boph P/ 4 boph

Comp. 100 bopd 2% wtr.

FABEN GILSTRAP

OVER