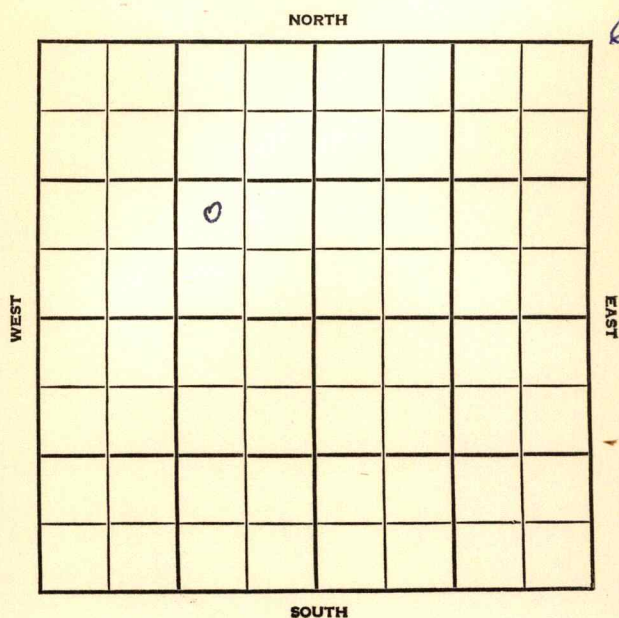


Section 25 Township 33 Range 14 WWell No. # 1 BaierCompany Lion Oil

Barber

KANSAS

SEC.	TWP.	R.
25	33	14W

WELL NO.

#1 Baier

FARM

COMPANY

Lion Oil

CONTRACTOR

Garvey

Medicine Lodge Pool

Ft. from N. Line

990


Ft. from S. Line

990

Ft. from E. Line

Ft. from W. Line

NW SE NW

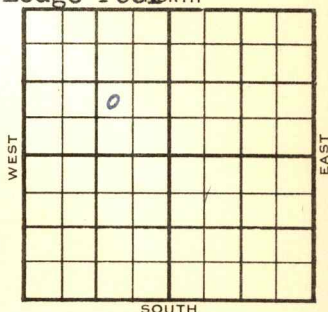

1955

ELEVATION

1834'

REPORT

2/9

Spud 2-5-55

8" @ 240'

Drlg. 2130'

3/9

Spud 2-5-55 Gas well TD 4911

8" @ 240' Doug 4061 Doug sd 4069

Lans 4207', Miss 4750'

DST 4752-60 open 1 hr, gas 30 min,

rec 50' GCM 1545# DST 4762-87

open 1 hr. gas in 25 min, rec 80' GCM

1350#. DST 4790-4837 open 1 hr gas

in 19 min, rec 90' GCM 1500#

TD 4913'. Schl. Tops: Elgin sd 3874'

Oread 3985', Heeb 4022', Doug 4060',

Doug sd 4071', Lans 4205', Miss 4746'

Kh. 4894', TD 4911' 5" @ 4890'

18/4838-40 1000 A B/5 GWPH

SP 4816 42/4792-4806 1000 A

58/4771-81 6/4756-60 frac.

Comp. 8,406,000 CFGPD


COMPLETED

County Barber State Kansas
 Sec. 25 (Blk. 33 (Sur. 14W Map No.
 (Twp.) (Rge.)

Operator Lion Oil

Well No. 1 Farm Baier

Elev. 1834 Location NW SE NW

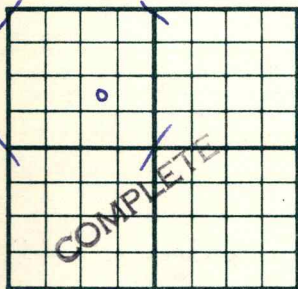

990 Ft. From S Line NW

990 Ft. From E Line Quarter

1st. Report

Completion MAR 9 1955

Remarks Medicine Lodge Pool

Garvey - Contr.

Spudding Date 2-5-55

Drlg. Data Gas well TD 4911

8" @ 240 Doug. 4061 Doug. sd. 4069

Lans. 4207 Miss. 4750 DST 4752-60

open 1 hr. gas in 30 min. Rec. 50' gcm

1545# DST 4762-87 open 1 hr. gas in

25 min. Rec. 80' gcm 1350# DST 4790-

4837 open 1 hr. gas in 19 min. Rec.

90' gcm 1500# TD 4913

SCHLUMBERGER TOPS:

Elgin sd. 3874 Oread 3985 Heeb. 4022

Doug. 4060 Doug. sd. 4071 Lans. 4205

Miss. 4746 Kh. 4894 TD 4911

5" @ 4890 18/ 4838-40 1000 A

B/ 5 gwph SP 4816 42/ 4792-4806

1000 A 58/ 4771-81 6/ 4756-60 frac

Comp. 8,406,000 cf gpd

FABEN GILCHRAP

County **Barber** State **Kansas**Sec. **25** (Blk. Twp.) **33** (Sur. Rge.) **14W** Map No.Operator **Lion Oil**Well No. **1** Farm **Baier**Elev. Location **NW SE NW**

990 Ft. From **S** Line **NW****990** Ft. From **E** Line Quarter1st. Report **FEB 9 1955**

Completion

Remarks

Garvey - Contr.Spudding Date **2-5-55**Drlg. Data **Medicine Lodge Pool****8" @ 240 drlg. 2130**

FABEN GILSTRAP