

Barber

KANSAS


SECTION 25 TOWNSHIP 33 RANGE 14 W

WELL NO. #2 Lenkner "C"

COMPANY G-M-R & Monsanto

NORTH

2

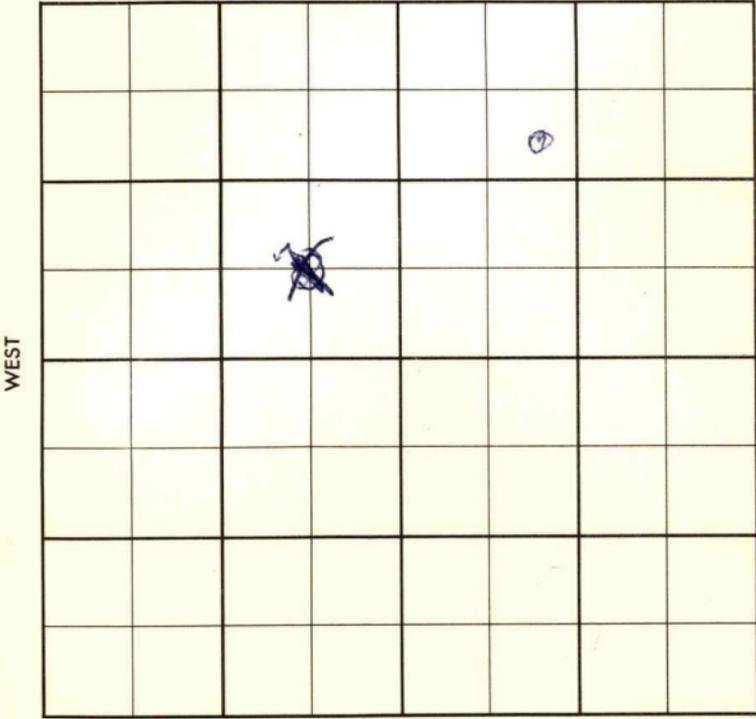

SOUTH

WEST

EAST

Barber

KANSAS

SEC. 25	TWP. 33 S	R. 14W
------------	--------------	-----------

WELL NO. #2 Lenkner "C" FARM

COMPANY G-M-R & Monsanto

CONTRACTOR G-M-R

Medicine Lodge


\_\_\_\_\_ Ft. from N. Line

\_\_\_\_\_ Ft. from S. Line

\_\_\_\_\_ Ft. from E. Line

\_\_\_\_\_ Ft. from W. Line

SE NW NE

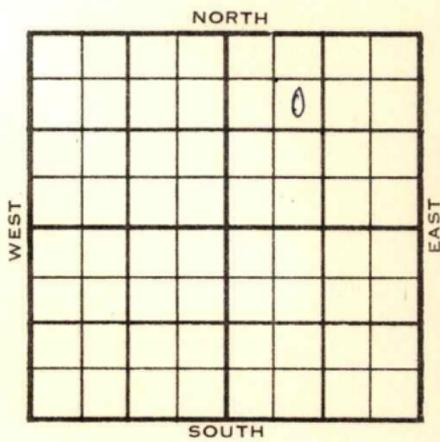

1956	ELEVATION 1860	REPORT
------	-------------------	--------

3-14 Comm. 3-7-56  
8" @ 266/175  
Drlg. 3281

3/28 Comm 3-7-56  
**L** 4221  
**M** 4757  
 TD 4763  
 8" @ 266/175 5 1/2" @ 4763/50  
 DD 4788 DD 4799  
 D & A

**ABANDONED**

County Barber Elev. \_\_\_\_\_  
 Sec. 25 Twp. 33 Rgs. 14W  
 Company G-M-R & Monsanto  
 Farm Name Lenkner "C" No. 2

TOPS	DEPTH	LOG	DATUM
Anh.			
Tp.			
H.			
Tr.			
Dg.			
Bl.			
L.			
K.C.			
B.K.C.			
Ce.			
C.			
M.			
M.			
K.			
Mz.			
Mq.			
V.			
S.			
S.			
A.			
R.			
Pf.			
G.			
T.D.			

Loc. in Sec. SE NW NE

Geol. \_\_\_\_\_  
 Contr. G-M-R

Pool Medicine Lodge



Date Comm. 3-7-56 MAR 14 1956  
8" @ 266/175 drlg. 3281

~~28~~

Co.  
Lse.  
No.  
Sec.  
T.  
R.

County Barber Elev. \_\_\_\_\_  
 Sec. 25 Twp. 33 Rgs. 14W  
 Company G-M-R & Monsanto  
 Farm Name Lenkner "C" No. 2

TOPS	DEPTH	LOG	DATUM
Anh.			
Tp.			
H.			
Tr.			
Dg.			
Bl.			
L.	<u>4221</u>		<u>2361</u>
K.C.			
B.K.C.			
Ce.			
C.			
M.	<u>4757</u>		<u>2897</u>
M.			
K.			
Mz.			
Mq.			
V.			
S.			
S.			
A.			
R.			
Pf.			
G.			
T.D.	<u>4763</u>		

Loc. in Sec. SE NW NE  
 Geol. \_\_\_\_\_  
 Contr. G-M-R  
 Pool Medicine Lodge



Date Comm. 3-7-56  
8" @ 266/175 5 1/2" @ 4763/50 DD 4788  
 DD 4799

D & A

Co.  
Lse.  
No.  
Sec.  
T.  
R.