


Barber

KANSAS

SECTION 28 TOWNSHIP 33S RANGE 14W

WELL NO. #1 U. R. Harbaugh

COMPANY Sun Oil Co.

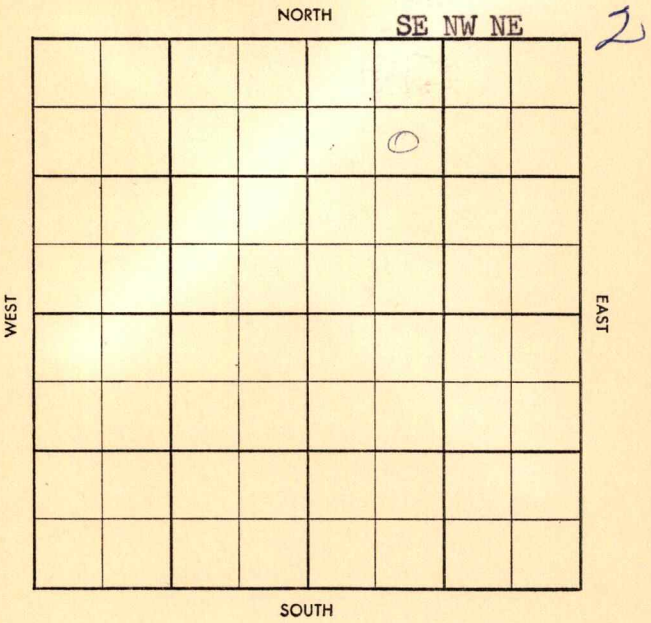

~~Twp. Pool~~

~~Co. Facet~~

*Medicine Lodge*

S-513-B

County Barber Elev. \_\_\_\_\_

Sec. 28 Twp. 33 Rge. 14W

Company Sun Oil Co.

Farm Name U. R. Harbaugh No. 1

TOPS	DEPTH	LOG	DATUM
Anh.			
Tp.			
H.			
Tr.			
Dg.			
B.L.			
L.			
K.C.			
B.K.C.			
Ce.			
C.			
M.			
M.			
K.			
Mz.			
Mq.			
V.			
S.			
S.			
A.			
R.			
Pf.			
G.			
T.D.			

Loc. in Sec. \_\_\_\_\_

SE NW NE

Geol. \_\_\_\_\_

Contr. \_\_\_\_\_

Capitt Drlg.

Pool \_\_\_\_\_

Med. Lodge W.

Date Comm. \_\_\_\_\_

Location

\_\_\_\_\_

\_\_\_\_\_

\_\_\_\_\_

\_\_\_\_\_

\_\_\_\_\_

\_\_\_\_\_

Co.  
Lse.  
No.  
Sec.  
T.  
R.


Twp. ~~X~~ Pool Med Lodge  
 Co. ~~X~~ Facet ~~X~~

S-513-B

County Barber Elev. 1670 DF 1673 RB  
 Sec. 28 Twp. 33 Rge. 14W  
 Company Sun Oil Co.  
 Farm Name U. R. Harbaugh No. 1

TOPS	DEPTH	LOG	DATUM
Anh.			
Tp.			
H.			
Tr.			
Dg.		3906	
B.L.			
L.		4073	
K.C.			
B.K.C.			
Ce.			
C.			
M. <u>dolo</u>		4618	
M.			
K.			
Mz.			
Mq.			
V.			
S.			
S.			
A.			
R.			
Pf.			
G.			
T.D.	4715	4680	

Loc. in Sec. SE NW NE  
 Geol. \_\_\_\_\_  
 Contr. \_\_\_\_\_  
Capitt Dalg.  
 Pool \_\_\_\_\_  
Med. Lodge W.

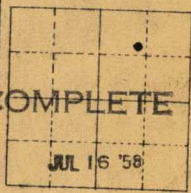

Date Comm. 5-29-58  
 Location JUN 3 '58 13 3/8 80/75 8" 392/375  
Ø 2130 JUN 11 '58 64165 JUN 18 '58 JUN 25 '58  
5 1/2 4714/100 CO 4686 320/  
4626-66 (1/2) Frac 30x30  
ga 4.000 MCF 8 1/2 hrs 20/64" TBg  
CHK FTP 1200 JUL 2 '58 51 TP  
1650 2 1/2 hrs JUL 9 '58 51 JUL 16 '58  
Co op Flo 10.000 mcf  
51 TP 1624 1 CSO 9.559  
mcf