

Barber

KANSAS

SECTION 28 TOWNSHIP 33S RANGE 14W

WELL NO. #1 Wheat

COMPANY Magnolia Petr. Co. C N W S E


NORTH

~~NW NW SE~~

10

WEST

EAST

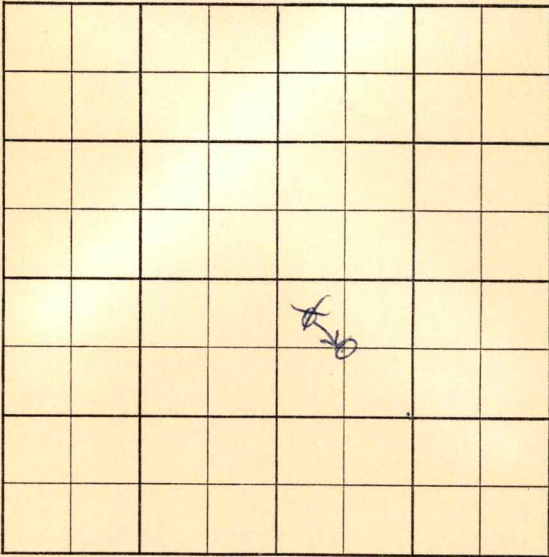

SOUTH

X Med Lodge
 Twp. _____ Pool _____
CORRECTION
 Co. _____ Facet _____


S-513-B

County Barber Elev. 16330' 16364'
 Sec. 28 Twp. 33 Rge. 14W
 Company Magnolia Pet. Co.
 Farm Name Wheat No. 1

TOPS	DEPTH	LOG	DATUM
Anh.			
Tp.			
H.	3843	3840	
Tr.			
Dg.			
B.L.			
L.	4036	4034	
K.C.			
B.K.C.			
Ce.			
C.	4597	4580	
M.			
M.			
K.			
Mz.			
Mq.			
V.			
S.			
S.			
A.			
R.			
Pf.			
G.			
T.D.	4685	4687	

Loc. in Sec.
 NW NW SE
 CNWSE

 Geol. _____
 Contr. _____
Prime Drlg.
 Pool _____
Med. Lodge W.

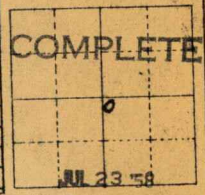

Date Comm. 6-19-58 8" 374/325
 Location JUN 25 '58 Ø 2500 JUL 2 '58 Ø 4148
JUL 9 '58 DST 4590 - 4620 95" g/l3"
ga 4990 muf / 10" rec 155'
gcm FP 55 - 110 BHP 1870 - 1820
DST 4628 - 85 1hr 40' gcm
FP 15 - 40 BHP 1105 - 1320
log 5 1/2 4684/200 JUL 16 '58 CD
4656 120/4584 - 4614 2 rec ld
ga 1.250 - muf 20/64" ck

Co.
 Lse.
 No.
 Sec.
 T.
 R.

F TP 460 FCP 550 from 20x20
Flid + 4.735 met 20/64 CK
FTP 1300 FCP 1500 SI wopot
SICP 1600 Jul-3-58 ca op Flid 13.672
my SICP 1631 SITP 1631

Twp. ~~X~~ Pool ~~Medicine~~

Co. ~~X~~ Facet ~~36~~ Lodge

S-513-B

County Barber Elev. _____

Sec. 28 Twp. 33 Rge. 14W

Company Magnolia Pet. Co.

Farm Name Wheat No. 1

TOPS	DEPTH	LOG	DATUM
Anh.			
Tp.			
H.			
Tr.			
Dg.			
B.L.			
L.			
K.C.			
B.K.C.			
Ce.			
C.			
M.			
M.			
K.			
Mz.			
Mq.			
V.			
S.			
S.			
A.			
R.			
Pf.			
G.			
T.D.			

Loc. in Sec. NW NW SE

Geol. _____

Contr. _____

Prime Drlg.

Pool _____

Med. Lodge W.

JUN 15 1969
FIRST REPORT

Date Comm. _____

Location

Co.

Lse.

No.

Sec.

T.

R.