

Barber


KANSAS

SECTION 28 TOWNSHIP 33S RANGE 14W

WELL NO. #1 Barthalomew

COMPANY Mull Drlg.

NORTH N/2  
8 NW NW

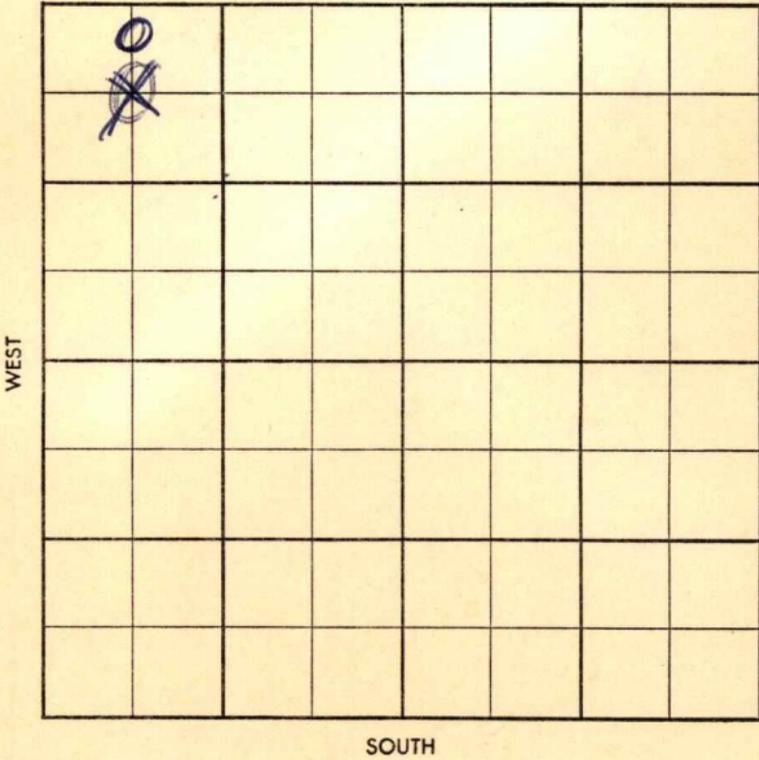

CORRECTION 26

S-513-A

CO ~~Barber~~ ELEV. <sup>1670</sup> 16670' FEB 12 '58

28 TWP. 33 RGE. 14W COMPLETE

COMPANY Mull Drlg. NO. 1 <sup>SDX</sup> 1/2 mile

FARM Barthelomew Sun - Ac.

LOC. ~~0 NW 1/4~~ <sup>approx</sup> NW 1/4 NW NW

2 1/2 S 250' W OF NE NW NW

H 3884

Dg 3983

L 4075

Miss 4641

TD4645

GEOL.

CONTR. Co. Tools

POOL Wildcat west

SPUD 12/22/57

8" @ 220 w/250, WOXmas

JAN - '58 Loss circle

skib rig 200'

WEST JAN 8 '58

resum 1-2-58

8" 824/175

JAN 15 '58 d 4420 JAN 22 '58 DST 4641

-61 60" g/17" ga 700 mcf/10"

ga 1.400 mcf/30" stabilized

rec 60' M BHP 1920 - 1890 1/2

DST 4661-81 120" g/12 1/2"

ga 1.790 mcf stabilized

nt rec 60' M EP 320-340

BHP 1880 - 1840 ~~instead~~

ran log 5 1/2 4685 west

Log top H 3882 Dg 3912

L 4077 m 4642 JAN 29 '58 Co 4681

not st 114/4643-81 ga

2.000 mcf not top

FEB 5 '58 free ga 8.500 mcf

2" thg CP 1480 Ca

29,000 mcf + SPRAY oil

4 point FEB 12 '58 25,500 mcf SICP

1643

