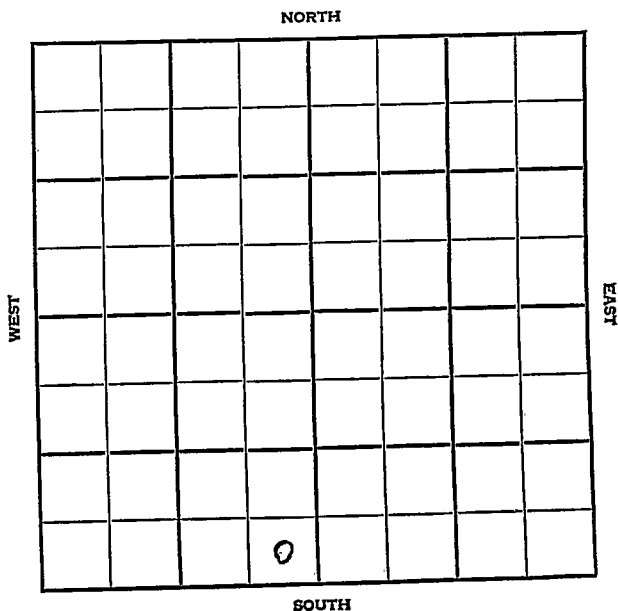


Section 14 Township 33 Range 42WWell No. 2 Kepner "A"Company Cities Service

Morton KANSAS

SEC.	TWP.	R.
14	33	42W

WELL NO.

2 Kepner "A"

FARM

COMPANY

Cities Service

CONTRACTOR

Holm Drlg.


Greenwood Pool

_____ Ft. from N. Line

330 _____ Ft. from S. Line

330 _____ Ft. from E. Line

_____ Ft. from W. Line

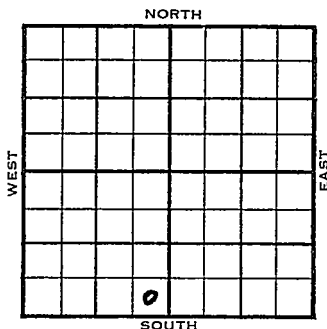

SE SE SW

1954	ELEVATION	REPORT
	3490'	

9/8 Spud 9-1-54
8" @ 600' - WOC

10/13 Spud 9-1-54 Gas well TD 3355
8" @ 600 Anhy 1388' Top 2934'
Lans. 3188 ID 3355 5" @ 3353
Co to 3287 60/3252-64 100/3226-46
80/3206-22 60/3190-3202 2,846,000
CFG 5000 A 17,000,000 CFG SP 3150
25/3102-07 80/3080-96 4,255,000
CFG 40/3048-76 5000 A 15,100,000
CFG 2000 A Comp. 28,400,000 CFGPD
418#

COMPLETED

