


DX 78-1 Morton

KANSAS

Section 14 Township 33 Range 43W

Well No. #1 Friend

Company Panhandle Eastern

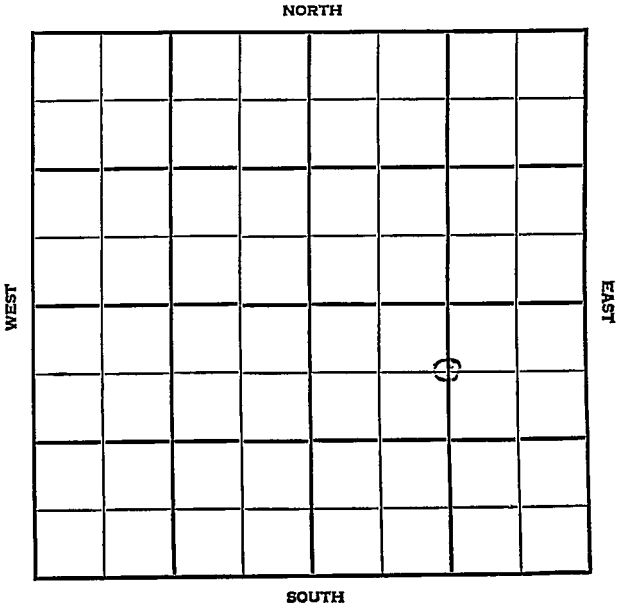

Morton

KANSAS

SEC.	TWP.	R.
14	33	43W

WELL NO.

1 Friend

FARM

COMPANY

Panhandle Eastern

CONTRACTOR

Moran

Freenwood Pool

Ft. from N. Line


2460'

Ft. from S. Line

1336'

Ft. from E. Line

Ft. from W. Line

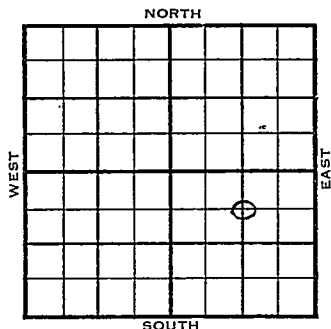C N $\frac{1}{2}$ SE

1955

ELEVATION

3583

REPORT

6/1

Spud 5-25-55
 10" @ 600 w/400
 Drlg 1826


6/29

Comm 5-25-55
 Anh Waub 2633, Tp 2868, L 3117,
 TD 3245
 10" @ 600/400 7" @ 3220/300 CO
 perf/3163-69 3149-60 464 mcfg
 perf/3126-42 803 mcfg 2000 A
 4,977 ~~mx~~ mcfg 5000 A 6,397 mcfg
 8 gwph PB 3090 perf 3004-15
 1,597 mcfg 1000 A 8,366 mcfg
 4000 A CO to 3200 15,273 mcfg
 PB 3990 20/2952-57 16/2945-49
 44/2931-42 20/2911-16 32/2896-2904
 2000 A 9,420 mdfig 6000 A CO to 3200
 19,794 mcfg 8000 A 20,407 mcfg
 Comp 33,885 mcfigpd 387#

COMPLETED

County Morton Elev. 3583
 Sec. 14 Twp. 33 Rge. 43W
 Company Panhandle Eastern
 Farm Name Friend No. 1

TOPS	DEPTH	LOG	DATUM	Loc. in Sec.
Anh. <u>Waub</u>	<u>2633</u>			<u>C N¹/₂ SE</u>
TP.	<u>2868</u>			
H.				<u>2460' SL</u>
Tr.				
Dg.				<u>1336' EL</u>
Bl.				
L.	<u>3117</u>		<u>4666</u>	Geol. _____
K.C.				Contr. _____
B.K.C.				
Ce.				<u>Moran</u>
C.				
M.				Pool _____
M.				<u>Greenwood</u>
K.				
Mz.				
Mq.				
V.				
S.				
S.				
A.				
R.				
Pe.				
G.				
TD.	<u>3245</u>			

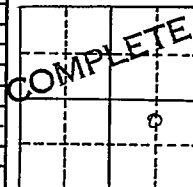

Date Comm. 5-25-55 JUN 29 1955

10" @ 600/400 7" @ 3220/300 CO

perf/3163-69 3149-60 464 mcf/g

perf/ 3126-42 803 mcf/g 2000 A

4,977 mcf/g 5000 A 6,397 mcf/g

8 gwph PB 3090 perf/ 3004-15

1,597 mcf/g 1000 A 8.366 mcf/g 4000 A

CO-to 3200 15,273 mcf/g PB 2990

20/ 2952-57 16/ 2945-49 44/ 2931-42

20/ 2911-16 32/ 2896-2904 2000 A

9,420 mdfg 6000 A CO to 3200

19,794 mcfg 8000 A 20,407 mcfg

Comp. 33,885 mcfgpd 387#

_____	Misc.
_____	Pierce Map.
_____	France Map
_____	Tracings
_____	Land Wall Map
_____	Land Small Map
_____	Scout Cards
_____	1955

JUL 8 1955

County Morton State KansasSec. 14 (Blk. Twp.) 33 (Sur. Rge.) 43W Map No.Operator Panhandle EasternWell No. 1 Farm FriendElev. Location C N $\frac{1}{2}$ SE

2460Ft. From S Line SE1336Ft. From E Line Quarter1st. Report JUN 1 1955

Completion

Remarks

Moran - Contr.Spudding Date 5-25-55Drlg. Data Greenwood Pool10" @ 600 w/ 400 drlg. 1826

11-511
K-21