


KANSAS

Stavens

Section 14 Township 33 Range 36W

Well No. #1 Barber

Company Northern Nat.

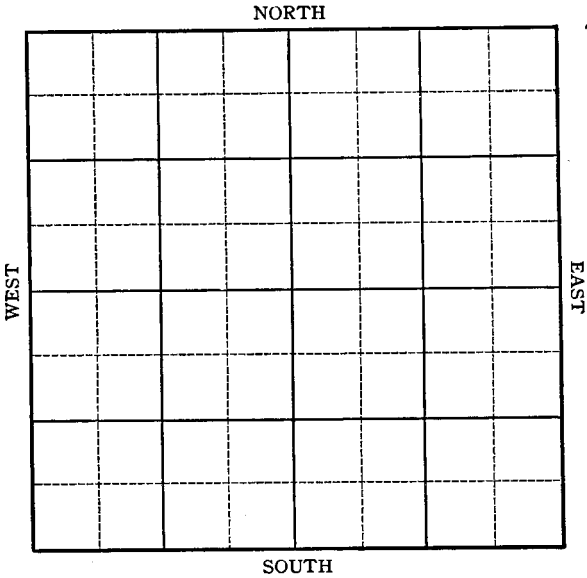

KANSAS

Stevens

Sec. 14 Twp. 33 R. 36W

Well No. #1 Barber Farm

Northern Nat. Company


Hugoton

100 Ft. from N. Line

 Ft. from S. Line

 Ft. from E. Line

100 Ft. from W. Line

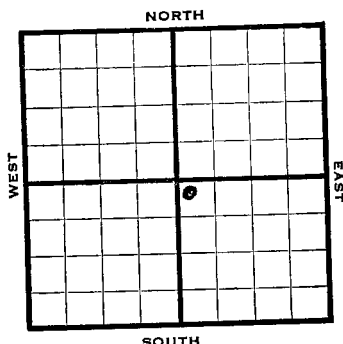

1944

REPORT

8/2

Location

8/9

"

8/16

"

8/23

"

8/30

"

9/8

"

9/13

10" @ 620' Drlg. 1785

9/21

TD 2655 7" @ 2650 RUST

9/28

" " " " " "

10/4

" " " " " "

10/11

" " " " " "

10/18

TD 2801

181' of 5" Perf. liner 12500 acid

10/25

" " " " " "

11/1

7" @ 2650'

181' of 5" Perf. liner @ 2801
12,500 acid

TD 2801'

15,504,000 gas

COMPLETED

Pool Name Hugoton PoolMap No. nm Sec. 14 Twp. 33 R. 36WWell No. 1 BarberNorthern Nat.

Company

COMPLETED

Contractor


NW SE

SECTION PLAT

100 Ft. from N. Line

Ft. from S. Line

Ft. from E. Line

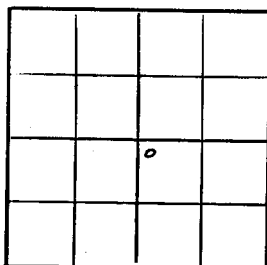100 Ft. from W. LineStevens

Location

Rig up

Drilling and Remarks:

7" C 2650

18 1/2" x 5" Perf. hole

C 2801

12500 acid

15,504,000 Gas

C/L

RECORD

Cased _____ in., _____ ft.

Sand _____

Gas _____

Oil _____

Total Depth 2801

PRODUCTION

1st 24 hrs. Nat. _____

1st 24 hrs. after shot _____

Gas _____ Cu. Ft.

Dry Hole _____

Abandoned _____

Date

NOV 1 1914 19

S. J. LEWIS

Scout


Pool Name Hugoton

KANSAS

Map No. X/M Sec. 14 Twp. 33 R. 36WWell No. 1 BarberNorthern Nat. CompanyFIRST REPORT Contractor

NW SE

SECTION PLAT

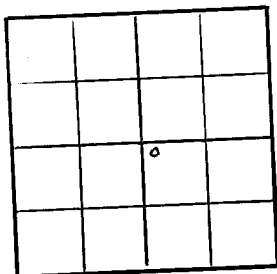100 Ft. from N. Line Ft. from S. Line Ft. from E. Line100 Ft. from W. LineStavens CountyLocation XRig up

Drilling and Remarks:

RECORD

Cased in., ft.Sand Gas Oil Total Depth

PRODUCTION

1st 24 hrs. Nat. 1st 24 hrs. after shot Gas Cu. Ft.Dry Hole Abandoned

Date

AUG 2 1944 19S. J. LEWIS Scout