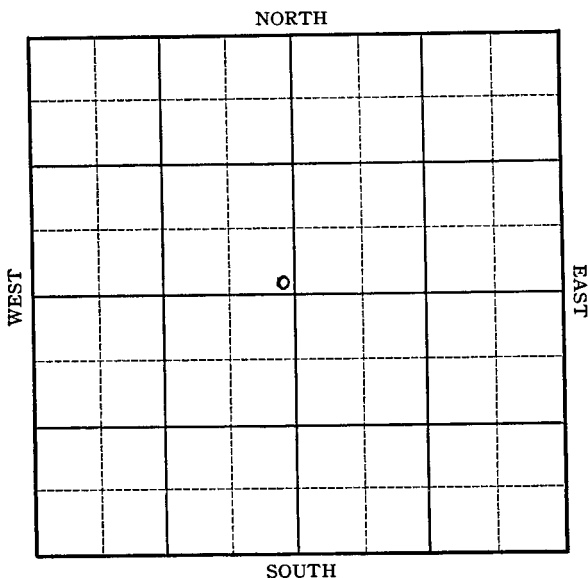
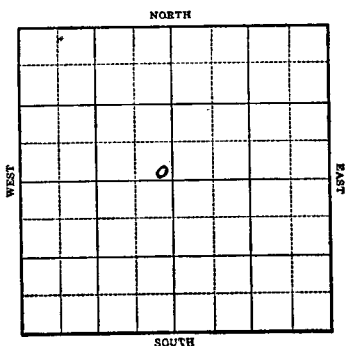


KANSAS

FORM 51 5M 1-42 PETROL

Stenens

Section 14 Township 33 Range 37-WWell No. π2 AlbertCompany Northern Nat'l Gas

Sec. 14 Twp. 33 R. 37-WWell No. #2 Albert FarmNorthern Nat'l Company Ft. from N. Line100 Ft. from S. Line Ft. from E. Line100 Ft. from W. Line

1943

R E P O R T

9/22

10" @ 555'

7" @ 2597'

Ft. Riley 2732

Pay 2750-55

2 M gas.

Drlg. 2765'

9/29

T.D. 2818

11,000 acid 8 M. Gas.

10/6

" " " "

10/13

" " " "

10/20 SD

10/27 T.D. 2818 SD

11/3

" " "

11/10

Sand 2597

7" @ 2597

11,000 acid

T.D. 2765


21,816,000 Cu Ft. Gas.

COMPLETED

KANE
Map No. 1111 Sec. 14 Twp. 33 R. 37WWell No. 2 AlbertNorthern Nat'l CompanyCOMPLETED Contractor

SW NW

SECTION PLAT

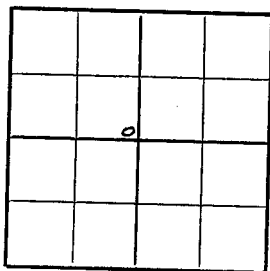

Ft. from N. Line

100 Ft. from S. Line100 Ft. from E. Line

Ft. from W. Line

Houghton Gas Pool

Location _____

Rig up _____

Drilling and Remarks:

Land 25972" @ 259711,000 acft21, 816, 000 cu ft
Gas.

RECORD

Cased _____ in., _____ ft.

Sand _____

Gas _____

Oil _____

Total Depth 2765

PRODUCTION

1st 24 hrs. Nat. _____

1st 24 hrs. after shot _____

Gas _____ Cu. Ft.

Dry Hole _____

Abandoned _____

Date

NOV 10 1943 19

S. J. LEWIS Scout

KANSAS
 Map No. 1111 Sec. 14 Twp. 33 R. 37W

Well No. 2 Albert


Northern Nat'l Gas Company

CORRECTION

Contractor

SW NW

SECTION PLAT

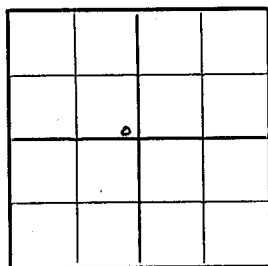

 Ft. from N. Line

100 Ft. from S. Line

 Ft. from E. Line

100 Ft. from W. Line

Houghton Gas Pool

Location

Rig up

Drilling and Remarks:

Spotted wrong

RECORD

Cased in., ft.

Sand

Gas

Oil

Total Depth

PRODUCTION

1st 24 hrs. Nat.

1st 24 hrs. after shot

Gas Cu. Ft.

Dry Hole

Abandoned

Date

SEP 29 1943

19

S. J. LEWIS

Scout

Stevens

KANSAS

Map No. 11 Sec. 14 Twp. 33 R. 37WWell No. 2 Albert

Northern Nat'l


Company

FIRST REPORT

Contractor

SW NW

SECTION PLAT

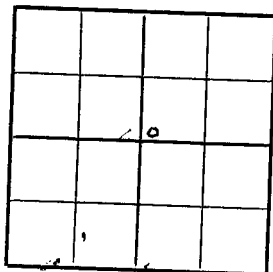

Ft. from N. Line

100 Ft. from S. Line100 Ft. from E. Line100 Ft. from W. Line

Houghton Gas Pool

Location

RECORD

Rig up

Cased _____ in., _____ ft.

Sand _____

Gas _____

Oil _____

Total Depth _____

Drilling and Remarks:

10 " - 555

7 " - 2597

Ft. Riley 2732

Pay 2750-55

2M Gas

2765 Drill

PRODUCTION

1st 24 hrs. Nat. _____

1st 24 hrs. after shot _____

Gas _____ Cu. Ft.

Dry Hole _____

Abandoned _____

Date

SEP 22 1943

19

S. J. LEWIS

Scout