


Section 14 Township 33 Range 34W

Well No. #1 L. Maddox

Company Cabot Carbon

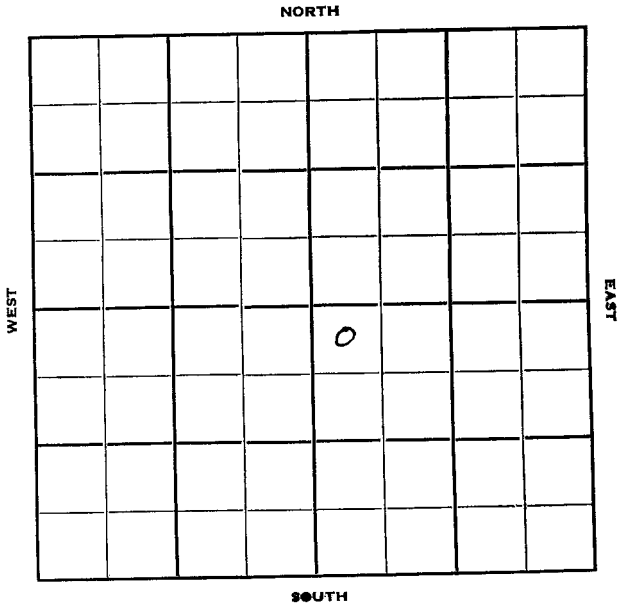


Sec. 14 Twp. 33 R. 34-W ✓

Well No. #1 L. Maddox Farm
Cabot Carbon Company

Hugoton Contractor

330 Ft. from N. Line
Ft. from S. Line
Ft. from E. Line
330 Ft. from W. Line

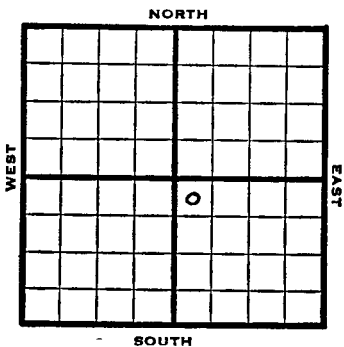

JW NW SE

1950 Elev. 2883' REPORT

12/13 Spud 12-1-50
10" @ 494
Drlg 1850'

1951
3/14 Spud 12-1-50
Gas well Td 2692'
10" @ 494, 7" @ 2220, TD 2692'
Her. 2600, Krider 2619,
Comp. 15,600,000 gas 421#

COMPLETED

County **Seward** State **Kansas**

Sec. **14** (Blk. Twp.) **33** (Sur. Rge.) **34W** Map No.

Operator **Cabot Carbon**

Well No. **1** Farm **L. Maddox**

Elev. _____ Location **NW NW SE**

330 Ft. From **N** Line **SE**
380 Ft. From **W** Line **Quarter**

1st. Report **DEC 13 1950**

Completion _____

Remarks _____

Spudding Date **12-1-50**

Drlg. Data **Hugoton Pool**

10" @ 494 drlg. 1850

