


Section 14 Township 33 Range 38W

Well No. #1 Wittman

Company McHeney

Hugoton Pool NORTH

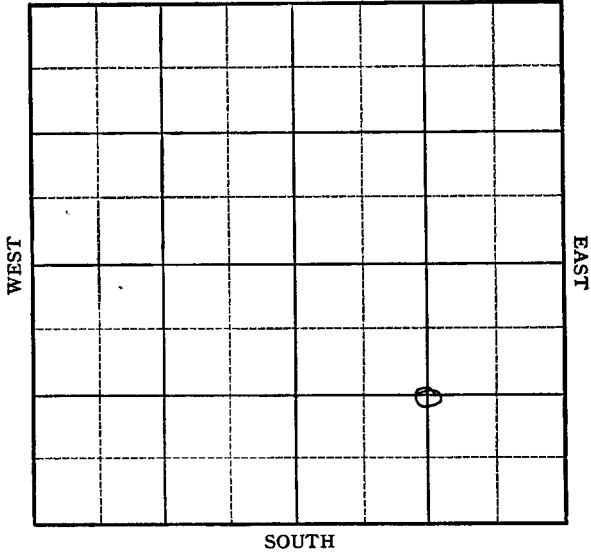

Stevens

KANSAS  
38W

Sec. 14 Twp. 33 R.

Well No. #1 Wittman Farm

McHeney

Company

Hugoton Pool (Burris, Contr.)

NORTH


1320' Ft. from N. Line

Ft. from S. Line

1320' Ft. from E. Line

Ft. from W. Line

C SE

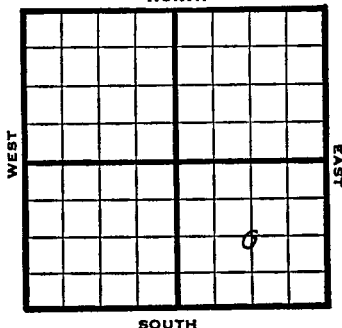

1949

Elev 3149'

REPORT

2/21

Location

12/28

"

1950

2/8

TD 2747'

10" set 582'

7" set 2494'

Cr 2543'

Win 2611'

Ft R 2666'

18,239,000 CFGPD

Comp

COMPLETED

Map No. \_\_\_\_\_ Sec. 14 Twp. 33 R. 38W

Well No. 1 Wittman

McHenry

Company

Burris

Contractor

C SE


1320 Ft. from N. Line

Ft. from S. Line

1320 Ft. from E. Line

Ft. from W. Line

SECTION PLAT  
FIRST REPORT

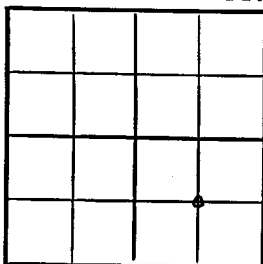

Stevens County

RECORD

Location X

Cased \_\_\_\_\_ in., \_\_\_\_\_ ft.

Sand \_\_\_\_\_

Gas \_\_\_\_\_

Oil \_\_\_\_\_

Total Depth \_\_\_\_\_

Rig up \_\_\_\_\_

Drilling and Remarks:

PRODUCTION

1st 24 hrs. Nat. \_\_\_\_\_

1st 24 hrs. after shot \_\_\_\_\_

Gas \_\_\_\_\_ Cu. Ft.

Dry Hole \_\_\_\_\_

Abandoned \_\_\_\_\_

Date

DEC 21 1944

19

S. J. LEWIS

Scout

Map No. \_\_\_\_\_ Sec. 14 Twp. 33 R. 38WWell No. 1 WittmanMcHenry

Company

Contractor

C SE

El. 3149


## SECTION PLAT

1320 Ft. from N. Line

\_\_\_\_\_ Ft. from S. Line

1320 Ft. from E. Line

\_\_\_\_\_ Ft. from W. Line

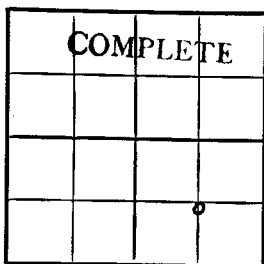Stevens County

## RECORD

Location \_\_\_\_\_

Cased \_\_\_\_\_ in., \_\_\_\_\_ ft.

Rig up \_\_\_\_\_

Sand \_\_\_\_\_

Drilling and Remarks:

Gas \_\_\_\_\_

10" @ 582

Oil \_\_\_\_\_

7' @ 2494Total Depth 2747Cr. 2543

## PRODUCTION

Win 2611

1st 24 hrs. Nat. \_\_\_\_\_

Ft. R. 2666

1st 24 hrs. after shot \_\_\_\_\_

18,239,000

Gas \_\_\_\_\_ Cu. Ft.

C.F.G.P.D

Dry Hole \_\_\_\_\_

Abandoned \_\_\_\_\_

Date

FEB 8 1950J. E. TYRA

Scout