

O.W.W.O.

Seward

KANSAS

14

33

32W

SECTION _____ TOWNSHIP _____ RANGE _____


WELL NO. #1 Alexander

COMPANY McKnab & Lindsay

NORTH

WEST

EAST

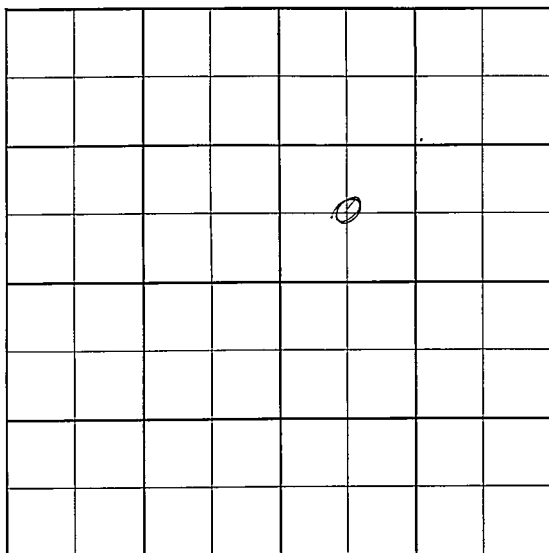

SOUTH

WILDCAT

O.W.W.O.

FORM 513 SUNRAY

County Seward Elev. 2777
 Sec. 14 Twp. 33 Rge. 32W
 Company McLamb & Lindsay
 Farm Name Alexander No. 1

TOPS	DEPTH	LOG	DATUM
Anh.			
Tr. <u>Hol.</u>	<u>2537</u>		
H. <u>Herr.</u>	<u>2600</u>		
Tr.			
Dg.			
Bl.			
L.	<u>1482</u>		
K.C.			
B.K.C.	<u>5114</u>		
Ce.			
C. <u>Marm.</u>	<u>5134</u>		
M. <u>Ce.</u>	<u>5205</u>		
M. <u>Atoka</u>	<u>5162</u>		
K. <u>Herr.</u>	<u>5668</u>		
Mz. <u>Chester</u>	<u>5824</u>		
Mo.			
V.			
S.			
S.			
A.			
R.			
Pe.			
G.			
TD.	<u>6106</u>		

Loc. in Sec. G SW NE

OWMO

Geol.

Contr.

Pool.

Wildcat

NOV 14 56

FIRST REPORT

Date Comm.

CO 6106 5" @ 6106 WOC

820 C C WOC

1.5.5

County Seward Elev. 2777
 Sec. 14 Twp. 33 Rge. 32W
 Company McKano & Lindsay
 Farm Name Alexander No. 1

TOPS	DEPTH	LOG	DATUM	Loc. in Sec.
Anh.				G. SW NE
Tp. <u>Hol.</u>	<u>2537</u>			
H. <u>Herr.</u>	<u>2600</u>			OWNO
Tr.				
Dg.				
BL				
L.	<u>4482</u>			Geol.
K.C.				Contr.
BKC.	<u>5114</u>			
Ce.				
C. <u>Flarm.</u>	<u>5134</u>			
M. <u>Co.</u>	<u>5295</u>			Pool
M. <u>Atoka</u>	<u>5466</u>			Wildcat
K. <u>Morr. sh</u>	<u>5668</u>	<u>5670</u>		
Nz. <u>Chester</u>	<u>5824</u>	<u>5936</u>		
Mo. <u>MW 5d</u>		<u>5805-18</u>		
V.				
S.				
S.				
A.				
R.				
PE.				
G.				
TD.	<u>6106</u>	<u>6034</u>		

Date Comm. CO 6106 5" @ 6106 WOC NOV 27 55 CO

6026 12/5964-67 no gas + 550
12/5876-80 no gas or oil A
8 Tr oil + 1 MILL CFG FVAC
3x3 8 5 Goph + 5 Bwp +
1 MILL CFG PB 5905 8 5 Goph
+ 5 Bwp + 1 MILL CFG PB
5840 20/5809-5814 est 9a 200
MCF + 5 Goph + 55W 172 8

ABANDONED

3/4 BFph (5040) + ga 200

MCF FRAC 12 X 10 NOV 28 '56

Lost Load

DEA