

KANSAS GEOLOGICAL SOCIETY
 KANSAS WELL LOG BUREAU - KANSAS WELL SAMPLE BUREAU
 KANSAS GEOLOGICAL SOCIETY BUILDING
 508 EAST MURDOCK - WICHITA, KANSAS

7-33-15W


COMPANY SUNRAY D X CO

SEC. 7- T. 33 R. 15W
 LOC. NE NE SE

FARM HAZEL D LANDON "B" NO. 1

COUNTY BARBER

TOTAL DEPTH 4940
 COMM. 4-30-64 COMP. 5-15-66
 SHOT OR TREATED
 CONTRACTOR STICKLE DRIG
 ISSUED 7-16-66

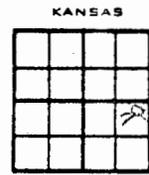

CASING
 20 10
 15 8
 12 6
 13 @ 231 9" @ 4920

ELEVATION 1775


PRODUCTION 3500 MCFGPD

FIGURES INDICATE BOTTOM OF FORMATIONS

Red bed	379
Red bed and shale	1114
Shale	1928
Lime and shale	2075
Shale	2265
Shale and lime	2398
Shale	3070
Shale and lime	4175
Lime and shale	4298
Broken lime and shale	4330
Lime	4433
Broken lime	4445
Lime	4820
Cherty lime	4827
Sand	4857
Lime and sand	4920
Lime and shale	4940 TD

TOPS:	SCOTT
HEEBNER	3905
LANSING	4063
BASE KANSAS CITY	4433
MISSISSIPPI	4646
VIOLA	4690
MARSHALL SD.	4847
SIMPSON	4874
SIMPSON BASE SD.	4886
TD.	4940

I, Fred E. Stickle, hereby certify the above to be a true and complete Driller's Log of Sunray DX Oil Company's Hazel Landon "B" No. 1 Well, NE NE SE Section 7-33E-15W, Barber County, Kansas.

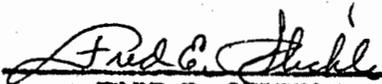
 FRED E. STICKLE


 Notary Public

My Commission Expires January 11, 1967