

KANSAS

FORM 51 5M BR1X

Stevens County

Section 15 Township 33 Range 36W

Well No. #1 Mueller

Company Northern Nat.

NORTH

SOUTH

WEST EAST

6

Stevens County

Sec. 15 Twp. 33 R. 36W

Well No. #1 Mueller Farm

Northern Nat. Company

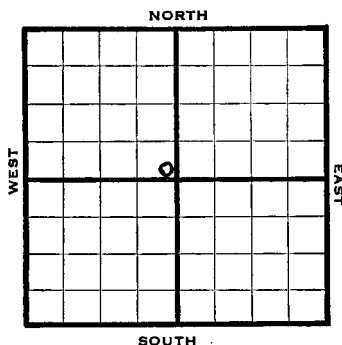
Hugoton

 Ft. from N. Line

100 Ft. from S. Line

100 Ft. from E. Line

 Ft. from W. Line



Elev 3032

REPORT

1944

7/12	Rotary
7/19	"
7/26	"
8/2	"
8/9	Surface Hole
8/16	10" @ 560'
8/23	2300 fsg
8/30	" "
9/8	" "
9/13	" "
9/21	7" @ 2630 TD RUST
9/28	TD 2827, 3/4 M gas
10/4	12500 acid
10/11	" "
10/18	200' of 5" Perf. liner
10/25	7" @ 2630' " "
11/1	200' of 5" Perf. liner @ 2827
	TD 2827'
	12500 acid
	20,080,000 gas.

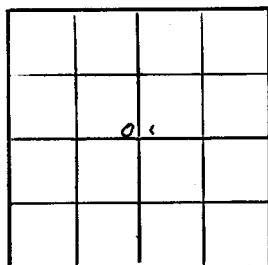
COMPLETED

Pool Name Hugoton PoolMap No. 17m Sec. 15 Twp. 33 R. 36WWell No. 1 MuellerNorthern Nat.

Company

COMPLETED

Contractor

SE NW**SECTION PLAT**

Ft. from N. Line

100

Ft. from S. Line

100

Ft. from E. Line

Ft. from W. Line

Stevens

Location

Rig up

Drilling and Remarks:

7" C 2680200' of 5" Pex linedC 2827.12500 gravel20,080,000 Gasg/lx.**RECORD**

Cased _____ in., _____ ft.

Sand _____

Gas _____

Oil _____

Total Depth 2827**PRODUCTION**

1st 24 hrs. Nat. _____

1st 24 hrs. after shot _____

Gas _____ Cu. Ft.

Dry Hole _____

Abandoned _____

Date

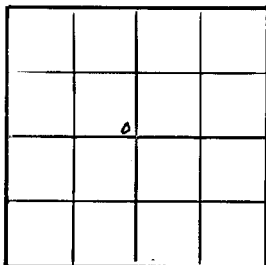
NOV 1 1944 19S. J. LEWIS

Scout

Pool Name HugotonMap No. KANSAS Sec. 15 Twp. 33 R. 36WWell No. 1 MuellerNorthern Nat. CompanyFIRST REPORT Contractor

SE NW

SECTION PLAT

 Ft. from N. Line100 Ft. from S. Line100 Ft. from E. Line Ft. from W. LineStevens County

RECORD

Location Cased in., ft.Rig up Sand

Drilling and Remarks:

Gas

Rotary

Oil Total Depth

PRODUCTION

1st 24 hrs. Nat. 1st 24 hrs. after shot Gas Cu. Ft.Dry Hole Abandoned

Date

JUL 1 2 1944 19S. J. LEWIS Scout