

1070113

Stevens


FORM 51 5M 10-41 PETROL

Section 15 Township 33 Range 37-W

Well No. #2 Kuhn

Company Republic Natural Gas

NORTH Houghton Pool

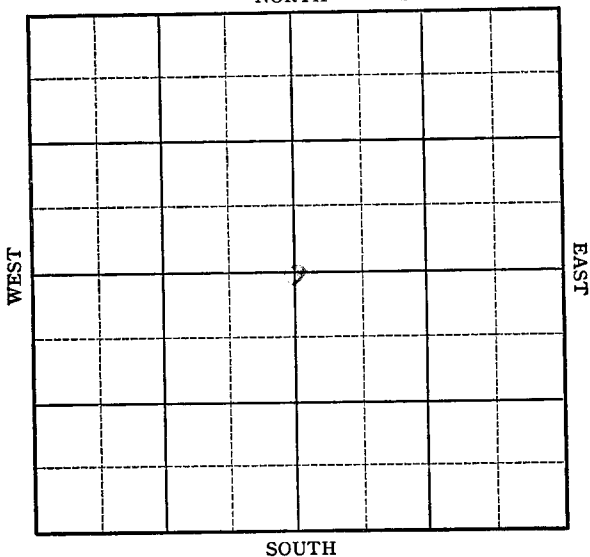

Map No. 111 Sec. 15 Twp. 33 R. 37W Stevens

Well No. 2 Kuhn

Republic Natural Gas Company

COMPLETE Contractor

C Sec.


_____ Ft. from N. Line

2590 Ft. from S. Line

2590 Ft. from E. Line

_____ Ft. from W. Line

SECTION PLAT

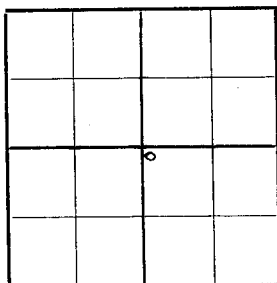

HOUGHTON POOL

Location _____

Rig up _____

Drilling and Remarks:

Herrington 2550

7" @ 2596

5000 acid

8 1/2 M Gas

RECORD

Cased _____ in., _____ ft.

Sand _____

Gas _____

Oil _____

Total Depth 2772

PRODUCTION

1st 24 hrs. Nat. _____

1st 24 hrs. after shot _____

Gas _____ Cu. Ft.

Dry Hole _____

Abandoned _____

Date

JUN 3 1942 19

S. J. LEWIS Scout

Stevens


KANSAS

Map No. MM Sec. 15 Twp. 33 R. 37WWell No. 2 KuhnRepublic Natural Gas CompanyFIRST REPORT

Contractor

C Sec.

SECTION PLAT

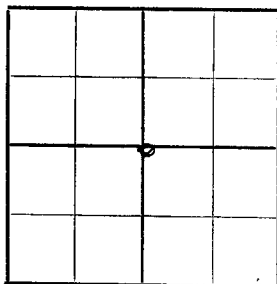 Ft. from N. Line2590 Ft. from S. Line2590 Ft. from E. Line Ft. from W. Line

HOUGHTON POOL

Location XXRig up

Drilling and Remarks:

RECORD

Cased in., ft.Sand Gas Oil Total Depth

PRODUCTION

1st 24 hrs. Nat. 1st 24 hrs. after shot Gas Cu. Ft.Dry Hole Abandoned

Date

APR 1 1942 19S. J. LEWIS Scout