FORM 51


Morton

KANSAS

Section 16 Township 33 Range 42W

Well No. #1 Baughman

Company Cities Service Oil Company

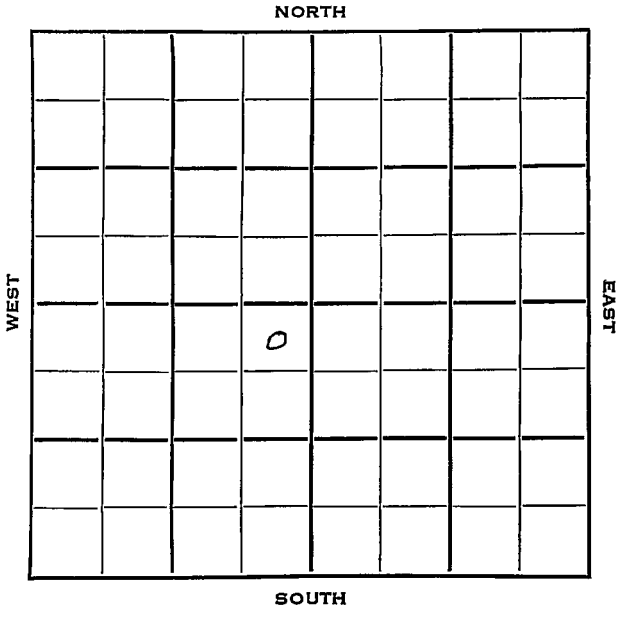

FORM 252-B
10M 8-51 TPCO.

Morton KANSAS

Sec. 16 Twp. 33 R. 42W

Well No. #1 Baughman Farm

Cities Service Company

Rine Drlg. Contractor


330 Ft. from N. Line

Ft. from S. Line

330 Ft. from E. Line

Ft. from W. Line

NE NE SW

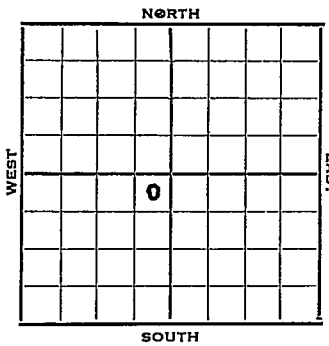

1953 Elev. 3509' REPORT

Lans. Test

2/25 Location

3/12 Schl Tops: Hugoton Zo 2205, Top 2900, Lans 3150
RTD 3409
5" @ 3350

3/19 NR

3/26 "

4/2 "

4/9 Testing

4/16 "

3509 − 2900 = 609

3509 − 315 = 3194

4/22 Spud 2-27-53
Gas Well
TD 3409'
8" @ 563
Top. 2900, Lans 3150,
TD 3409
5" @ 3350'
CO to 3233
40/ 3218-26 30/ 3208-14 110/ 3182-3204
mcfg 90/ 3154-72 6000 A SP 3118
25/ 3098-3103 30/ 3080-86 823,000 gas
155/ 3032-63 2,497,000 5000 A
CO to 3233 SP 3010 26/ 2986-90
60/ 2960-72 50/ 2940-50 20/ 2930-34

OVER

1953

Information brought forward

4/22 50/ 2904-14 16½ mcfg 5000 A
20 mcfg 1000 A
CO to 3233
8000 A 20,700,000 gas 2750 A
Comp. 24,700,000 gas 431#

COMPLETED

FORM 275 FOR SALE BY KANSAS BLUE PRINT CO.


County Morton State Kansas

Sec. 16 (Blk. Twp.) 33 (Sur. Rge.) 42W Map No.

Operator Cities Service

Well No. 1 Farm Baughman

Elev. Location NE NE SW

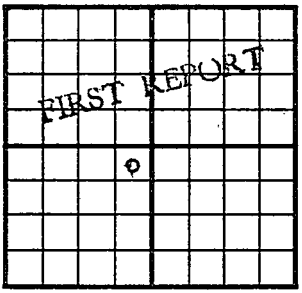

330 Ft. From N Line SW

330 Ft. From E Line Quarter

1st. Report FEB 25 1953

Completion

Remarks Lans. test
Rine Drlg. - Contr.

Spudding Date

Drlg. Data

Location

J. G. McGEHEE

FORM 275 FOR SALE BY KANSAS BLUE PRINT CO.


County Morton State Kansas

Sec. 16 (Blk. Twp.) 33 (Sur. Rge.) 42W Map No.

Operator Cities Service

Well No. 1 Farm Baughman

Elev. 3509 Location NE NE SW

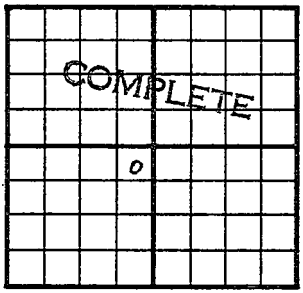

330Ft. From N Line SW

330Ft. From E Line Quarter

1st. Report

Completion APR 2 2 1953

Remarks

Rine Drlg. - Contr.

Spudding Date 2-27-53

Drlg. Data Gas well TD 3409

8" @ 563 Top. 2900 Lans. 3150 TD 3409

5" @ 3350 CO to 3233 40/ 3218-26

30/ 3208-14 110/ 3182-3204 mcfg

90/ 3154-72 6000 A SP 3118 25/ 3098-

3103 30/ 3080-86 823,000 gas

155/ 3032-63 2,497,000 5000 A

CO to 3233 SP 3010 26/ 2986-90

60/ 2960-72 50/ 2940-50 20/ 2930-34

50/ 2904-14 16 1/2 mcfg 5000 A

20 mcfg 1000 A CO to 3233 8000 A

20,700,000 gas 2750 A

Comp. 24,700,000 gas 431#

J. G. McGEHEE