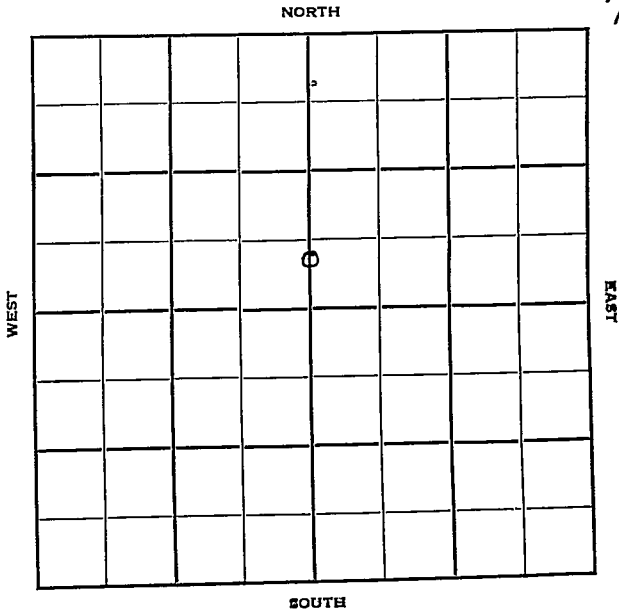


KANSAS

Morton

FORM 51 25M 3-49 PETROL

Section 16 Township 33 Range 40-WWell No. #1-16 Law (LOW)Company Panhandle Eastern

Morton KANSAS

Sec. 16 Twp. 33 R. 40W

Well No. #1-16 Law Farm

Panhandle Eastern Company

Contractor

Hugoton

2080' Ft. from N. Line


Ft. from S. Line

2640' Ft. from E. Line

Ft. from W. Line

560 N of C

Gas Well

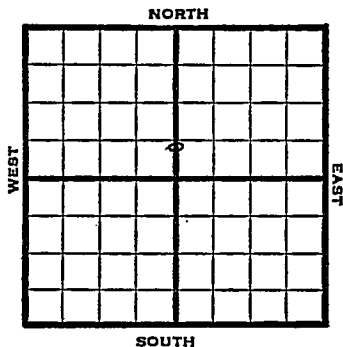

1950

REPORT

Elev 3297

5/31 Location

10/11 10" @ 521

7" @ 2285

TD 2457

Krider 2284

Win2360

Towanda 2423

5000 A

Comp 4,521,000 gas

Completed

COMPLETED

Kansas

Form 26 200 Bks. 11-49 Petrol

Map No. _____ Sec. 16 Twp. 33 R. 40W

Well No. 1-16 Law

Panhandle Eastern Company

Contractor

560 N of C

SECTION PLAT

		o	
FIRST REPORT			

2080 Ft. from N. Line

_____ Ft. from S. Line

2640 Ft. from E. Line

_____ Ft. from W. Line

Morton

Location X

Rig up _____

Drilling and Remarks:

RECORD

Cased _____ in., _____ ft.

Sand _____

Gas _____

Oil _____

Total Depth _____

PRODUCTION

1st 24 hrs. Nat. _____

1st 24 hrs. after shot _____

Gas _____ Cu. Ft.

Dry Hole _____

Abandoned _____

Date

MAY 31 1950
19

J E TYRA Scout

