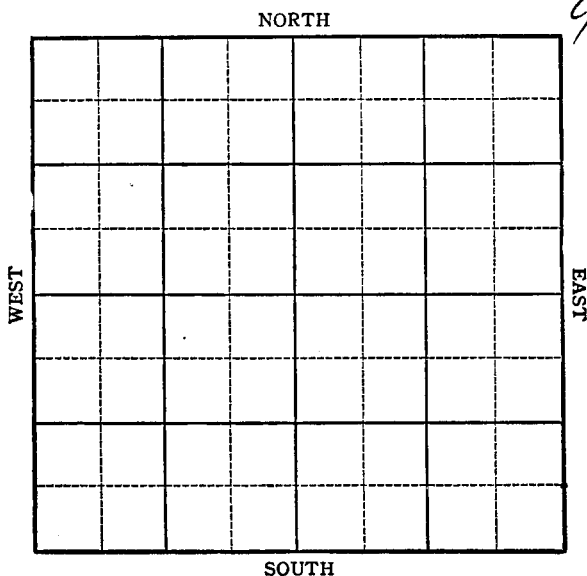


KANSAS Stevens County

Section 17 Township 33 Range 36WWell No. #1 HarrisonCompany Northern Nat.

KANSAS

Stevens County

Sec. 17 Twp. 33 R. 36W

Well No. #1 Harrison Farm

Northern Nat. Company

Hugoton


990 Ft. from N. Line

Ft. from S. Line

1320 Ft. from E. Line

Ft. from W. Line

C N $\frac{1}{2}$ SE

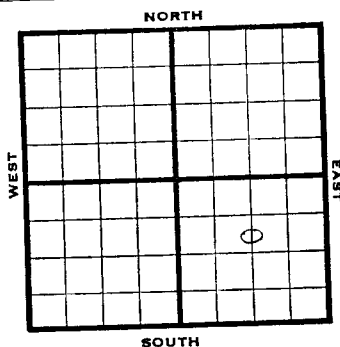

1944

R E P O R T

11/1 Location

11/8 "

11/16 "

11/24 "

11/29 "

12/6 "

12/14 "

12/21 "

12/29 "

1945

1/3 "

1/10 10" @ 572

Drlg 1751

1/17 Drlg 2265

1/26 7" @ 2865' TD

RUST

1/31 " " " "

2/7 " " " "

2/14 " " " "

2/21 " " " "

2/28 " " " "

3/7 " " " "

OVER

1945

3/14 TD 2758 104' of 5"
Perf Liner @ 2758 7 M gas

3/23 " " " " " "

3/29 12750 acid

4/4 7" @ 2665
104' of 5" Perf Liner @ 2758
12750 acid
22,280,000 Gas
TD 2758
377# R Pr.

COMPLETED

Pool Name HugotonMap No. 17 Sec. 17 Twp. 33 R. 36WWell No. 1 HarrisonNorthern Nat.


Company

COMPLETED

Contractor

C N $\frac{1}{2}$ SE

SECTION PLAT

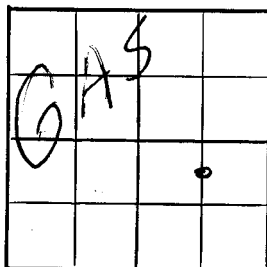990 Ft. from N. Line Ft. from S. Line1320 Ft. from E. Line Ft. from W. LineStevens CountyLocation Rig up

Drilling and Remarks:

7' 1" 2665104' 5" 2665@ 275812750 266522, 280,000 Gas377 #2 P

RECORD

Cased in., ft.Sand Gas Oil Total Depth 2258

PRODUCTION

1st 24 hrs. Nat. 1st 24 hrs. after shot Gas Cu. Ft.Dry Hole Abandoned

Date

APR 4 194519S. J. LEWIS Scout

Pool Name HugotonMap No. N 17 Sec. 17 Twp. 33 R. 36WWell No. 1 HarrisonNorthern Nat.


Company

FIRST REPORT

Contractor

C $N\frac{1}{2}$ SE

SECTION PLAT

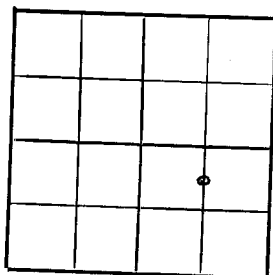990 Ft. from N. Line Ft. from S. Line1320 Ft. from E. Line Ft. from W. LineStevensLocation XRig up

Drilling and Remarks:

RECORD

Cased in., ft.Sand Gas Oil Total Depth

PRODUCTION

1st 24 hrs. Nat. 1st 24 hrs. after shot Gas Cu. Ft.Dry Hole Abandoned

Date

NOV 1 1944

19

S. J. LEWIS

Scout