


Meade

KANSAS

Section 17 Township 33 Range 30 W **KANSAS**

Well No. 1 G. Patterson

Company Columbian Fuel

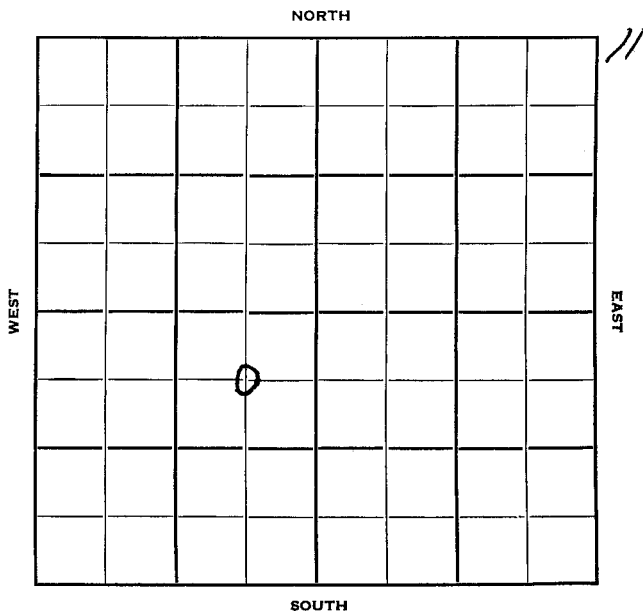

W.W.O.

Meade

KANSAS ✓

Sec. 17 Twp. 33 R. 30WWell No. 1 G. Patterson FarmColumbian Fuel Company

Contractor


660 Ft. from N. Line

Ft. from S. Line

660 Ft. from E. Line

Ft. from W. Line

C NE SW

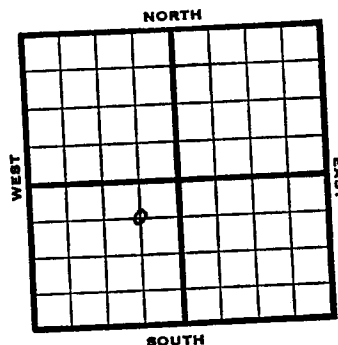

1953

Elev. 2732' REPORT

4/15

Location

4/23

"

4/30

13" @ 640'
Drlg 2060'

5/7

Willard 2110, Hol 2571, Her 2624
RTD 2645
8" @ 2600, CO

5/21

Coring.

5/28

Coring

6/3

NR

6/10

CO 5740' 54/5721-30 NS
500 A NS

6/24

NR

7/1

NR

9/30

Spud 4-23-53

D & A

TD 5925'

13" @ 640'

Well 2110, Hol. 2571, Her. 2624

TD 2645'

8" @ 2600'

OVER

1953

Information brought forward.

9/30 DST 5290-5320' opn 1 hr, rec 10' mud
120#.
DST 5675'-5710' opn 1 $\frac{1}{4}$ hr, rec 80' sm-
co & gas 1400#.
DST 5709'-43 opn 110 min, rec 20' omm,
130' mco, 1025#.
TD 5925'
5" @ 5770'
CO to 5740'
54/ 5721-30 500 A CO to 5718
78/ 5697-5712 492,000 gas 6 goph
500 A
604,000 gas 6 goph 2500 A
S/ 1 bf 2 hr.
495,000 gas 12000 A S/ 2 boph
268,000 gas S/ 5 bo 3 bw 8 hr.
1,600,000 gas SCHLUMBERGER TOPS
Kir 2694, Win 2746, Ft. Riley 2810
Florence Flint 2930, KC 4518, Marm
5132, Atoka 5421, Morrow 5650, Chester
5699
S/ 42 go 18 gw 2 hr.
24/ 5673-77 30/ 5691-96 5 go
10 gswph
D & A

ABANDONE

O.W.W.O.

1954
3/3

Hol. 2571 Her. 2624 Lans 4518
Marm. 5132 Novinger 5200 Cherokee
5300' Atoka 5421 Maro 5650'
Chester 5699 5" @ 5770 OTD 5925'
CO to 5141 24/5132-36 B/2 BSWPH
8 hr. SP 4882 24/4854-58 S/5 BSW
PB 4622 24/4586-92 FU 3000' SW
1 hr. PB 4470 60/4437-47 4 BSWPH
PB 4448 PB 4431 CO 4442

3/17

D & A TD 5925' Hol. 2571 Her 2624
Lans. 4518' Marm 5132 Novinger 5200
Cherokee 5300 Atoka 5421 Maro 5650
Chester 5699 5" @ 5770 OTD 5925'
CO to 5141 24/5132-36 B/2 BSWPH 8 h
SP 4882 24/4854-58 S/5 BSWPH PB 46
24/4586-92 FU 3000' SW 1 hr. PB 4470
60/4437-47 4 BSWPH PB 4448 PB 4431
CO to 4442 138/4397-4442 1 $\frac{1}{2}$ BW 8 hr
500 A 1 BWPH SP 4375 84/4330-44
500 A 6 BSWPH D & A

ABANDONED

County Neade State Kansas
 Sec. 17 (Bk.) 33 (Sur.) 30W Map No.
 Operator Columbian Fuel
 Well No. 1 Farm G. Patterson
 Elev. _____ Location C NW SW


FIRST REPORT

660 Ft. From N Line SW
660 Ft. From E Line Quarter
 1st. Report APR 15 1952
 Completion _____
 Remarks _____
 Spudding Date _____

Drig. Data _____

Location _____

J. G. McGENEE

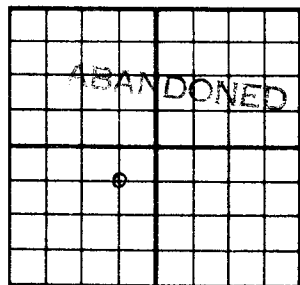County Deade State KansasSec. 17 (Blk. Twp.) 33 (Sur. Rge.) 30W Map No.Operator Columbian FuelWell No. 1 Farm G. PattersonElev. 2732 Location C NE SW660 Ft. From N Line SW660 Ft. From E Line Quarter

1st. Report


Completion SEP 30 1953

Remarks

Spudding Date 4-23-53Drilg. Data D & A TD592513" / 640 Well. 2110 Hol. 2571Per. 2624 TD 2645 8" C 2600DST 5290-5320 open 1 hr. Rec. 10' mud120# DST 5675-5710 open $1\frac{1}{2}$ hr. Rec.80' smco & gas 1400# DST 5709-43open 110 min. Rec. 20' ccm 130' mco1025# TD 5925 5" C 5770 CO to 574054/ 5721-30 500 A CO to 5718 78/ 5697-5712 492,000 gas 6 goph 500 A304,000 gas 6 goph 2500A S/ 1 bf2 hr. 436,000 gas 12000 A S/ 2 boph263,000 gas S/ 5 bo 3 bw 3 hr.1,600,000 gas SCHLIMBERGER TOBSTri. 2694 Win. 2746 Pt. Riley 2310

O.W.W.O.

County Leade State Kansas
 Sec. 17 (Bk. 33 (Sur. 30W Map No.
 (Twp.) (Rge.)
 Operator Columbian Fuel
 Well No. 1 Farm Grace Patterson
 Elev. 2732 Location 2 1/2 E SW

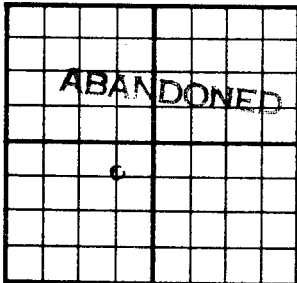

660 Ft. From N Line SW
660 Ft. From E Line Quarter

1st. Report

Completion MAR 17 1954

Remarks

O.W.W.O.

Spudding Date

Drlg. Data D & A TD 5925Pol. 2571 Mer. 2624 Lans. 4518Larn. 5132 Nowinger 5200 Cherokee 5300Atoka 5421 Maro 5650 Chester 56995" 5770 OTD 5925 20 to 514124/ 5132-33 E/ 3 bswph 3 hr. SP 438224/ 4854-58 S/ 5 bswph FB 462224/ 4586-92 FU 3000' sw 1 hr. FB 447060/ 4437-47 4 bswph IL 4448 FB 445160 to 4442 136/ 4307-4442 1 1/2 hr. 0 hr.500 A 1 bswph SP 4375 64/ 4330-44500 A 6 bswphD & A

J. G. McGEHEE

FIRST REPORT

Drlq. Data

Hol. 2571	Her. 2624	Lans. 4518
Marm. 5132	Novinger 5200	Cherokee 5300
Atoka 5421	Maro 5650	Chester 5699
g ⁿ @ 5770	OTD 5925	CO to 5141
24/ 5132-36	B/ 2 bswph	8 hr. SP 4862
24/ 4854-58	S/ 5 bswph	PB 4622
24/ 4586-92	PU 8000' sw	1 hr. PB 4470
60/ 4437-47	4 bswph	PB 4448 PB 4431
CO 4442		

J. G. McGEHEE