


Section 18 Township 33 Range 30W


Well No. #1 Langhofer

Company Shamrock Oil

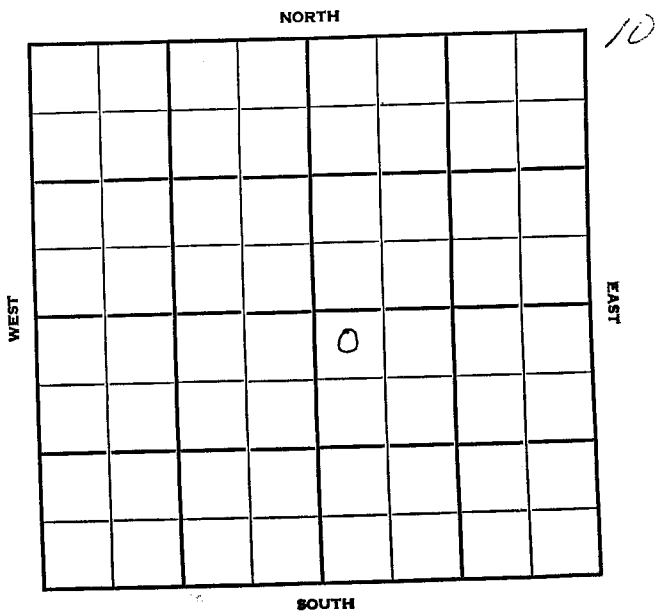

Meade		KANSAS
SEC. 18	TWP. 33	R. 30W
WELL NO. 1 Langhofer		
COMPANY Shamrock Oil		FARM
CONTRACTOR Geo Cree		

~~1980~~ 330 Ft. from N. Line
 _____ Ft. from S. Line
 _____ Ft. from E. Line
~~1980~~ 330 Ft. from W. Line
~~6 SE SE~~
 NW NW SE

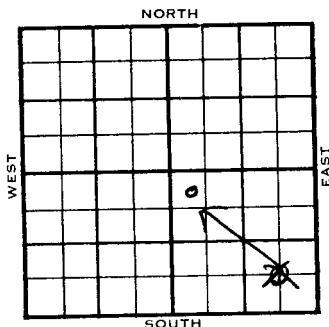

1955	ELEVATION 2738'	REPORT																								
6/22	Comm 6-21-55 Drlg 215																									
9-7	13" @ 638/500 9 5/8" @ 2630/300 DST 3108-47, open 70 min., rec. 90' mud 660' sw 715/30" DST 4980-90, open 1½ hr., rec. 625' sw 15' mud, 1540/30" DST 5600-57, open 70 min., gas in 5 min. 1,410 mcfg, rec. 5' mud, 1895/20" DST 5658-72, open 64 min. gas in 1½ mi 1,500 mcfg Rec. 5' mud, 1815/20" DST 5672-92, open 22 min. rec. 5' mud 0/20" 5½" @ 5693, CO to 5690, 30/ 5654-59, 84/ 5661-75 2,000 mcfg, 1000 A 6,092 mcfg frac Comp. 9 mcfgpd 1600#																									
	<table border="0" style="width: 100%;"> <tr> <th style="text-align: left;">Top</th><th style="text-align: left;">Depth</th><th style="text-align: left;">Log</th></tr> <tr> <td>L.</td><td></td><td>4494</td></tr> <tr> <td>Atoka</td><td></td><td>5393</td></tr> <tr> <td>Arm.</td><td>5124</td><td>5108</td></tr> <tr> <td>Ce</td><td></td><td>5275</td></tr> <tr> <td>Morr w</td><td>5604</td><td>5608</td></tr> <tr> <td>Miss</td><td></td><td>5664</td></tr> <tr> <td>T.D.</td><td>5698'</td><td></td></tr> </table>	Top	Depth	Log	L.		4494	Atoka		5393	Arm.	5124	5108	Ce		5275	Morr w	5604	5608	Miss		5664	T.D.	5698'		COMPLETED
Top	Depth	Log																								
L.		4494																								
Atoka		5393																								
Arm.	5124	5108																								
Ce		5275																								
Morr w	5604	5608																								
Miss		5664																								
T.D.	5698'																									

County Meade Elev. _____
Sec. 18 Twp. 33 Rge. 30W
Company Shamrock Oil
Farm Name Lanchofer No. 1

TOPS	DEPTH	LOG	DATUM
Anh.			
Tp.			
H.			
Tr.			
Dg.			
Bl.			
L.			
K.C.			
B.K.C.			
Ce.			
C.			
M.			
M.			
K.			
Mz.			
Mo.			
V.			
S.			
S.			
A.			
R.			
Pe.			
G.			
T.D.			

Loc. in Sec. _____
C SE SE
1980' NL
1980' WL
Geol. _____
Contr. _____
Geo. Cree
Pool _____
Wildcat


FIRST REPORT

X_o

Date Comm. 6-21-55
drlg. 215
14-205

County Meade Elev. 2738
 Sec. 18 Twp. 33 Rge. 30W
 Company Shamrock Oil
 Farm Name Langhofer No. 1

TOPS	DEPTH	LOG	DATUM	Loc. in Sec.
Anh.				NW NW SE
Tr.				
H.				
Tr.				
Dg.				
Bl.				
L.		4494	1756	
K.C.				Geol.
B.K.C.				Contr.
Ce.				Geo. Cree
Me.				
V.				
S.				
S.				
A				
R.				
P.				
G.				
T.D.	698			

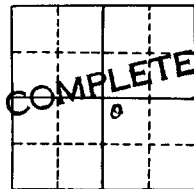

late Comm. 6-21-55 SEP 7 1955

13" @ 638/500 9 5/8" @ 2630/300

DST 3108-47 open 70 min. Rec. 90' mud

660' sw 715/30" DST 4980-90

open 1 1/2 hr. Rec. 625' sw 15' mud

1540/30" DST 5600-57 open 70 min.

gas in 5 min. 1,410 mcfg Rec. 5' mud

1895/20" DST 5658-72 open 64 min.

gas in 1 1/2 min. 1,500 mcfg Rec. 5' mud

OVER

1815/20" DST 5672-92 open 22 min.
Rec. 5' mud 0/20" 5 $\frac{1}{2}$ " @ 5693 CO to
5690 30/ 5654-59 84/ 5661-75
2,000 mcfg 1000 A 6,092 mcfg frac
Comp . 9 mcfgpd 1600#

Scout Cards
Land Small Map
Land Wall Map
Tracings
France Map
Pierce Map
Misc.

SEP 15 1955

SCOUT TICKET

DX-201

SEC.

TWP.

R.

18

33

30W

WELL NO.

1 Langhofer

COMPANY

FARM

Shamrock Oil

CONTRACTOR

CORRECTION

NW NW SE

330


FT. FROM N. LINE

FT. FROM S. LINE

FT. FROM E. LINE

330

FT. FROM W. LINE

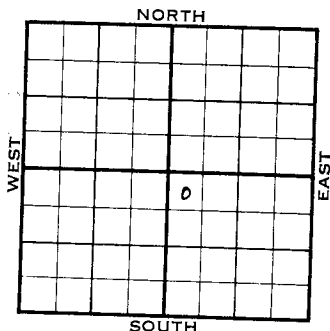

Meade County

☐ LOCATION☐ RIG UP

DRILLING AND REMARKS:

Reported

C SE SE

RECORD

CASED IN. FT.

SAND

GAS

OIL

TOTAL DEPTH

PRODUCTION

1ST 24 HRS. NAT.

1ST 24 HRS. AFTER SHOT

GAS CU. FT.

DRY HOLE

ABANDONED

DATE

SCOUT

SEP 7 1955

L. J. Harris