

KANSAS


Seward

Section 18 Township 33 Range 34W

Well No. 1 Marteney

Company Panhandle Eastern

Hugoton

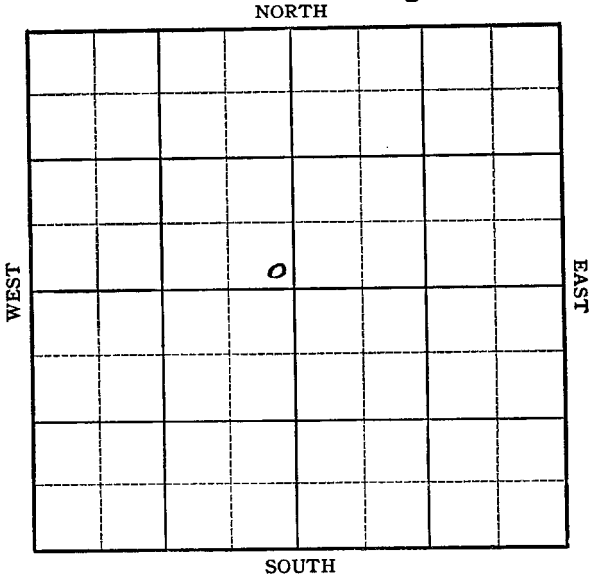

KANSAS

Seward

34W

Sec. 18 Twp. 33 R. 34W


Well No. #1 Marteney Farm

Panhandle Eastern

Company

Hugoton Pool (Moran, Cont.)

NORTH

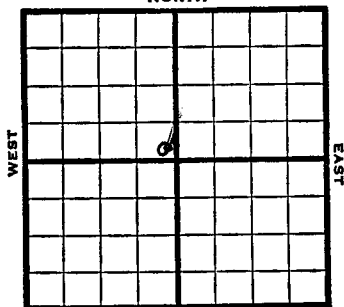

Ft. from N. Line

100'

Ft. from S. Line

100'

Ft. from E. Line

Ft. from W. Line

SE NW

SOUTH

1949 El. 2927' REPORT

5/25 Location

6/1 "

6/7 10" @ 568'
Drlg 750'

6/15 TD 2603'
7" @ 2596'

6/21 "

6/28 Drlg. 2750'

7/6 "

7/12 "

7/20 Complete

7" @ 2596'

165' of 5" Perf Liner @ 2750'

1,391,000 gas

438 # R Pe

TD 2750'

COMPLETED

Kansas

Hugoton Pool

Map No. _____ Sec. 18 Twp. 33 R. 34W

Well No. 1 Marteney

Pannandle Eastern

Company

Moran

Contractor

SE NW

FIRST REPORT
SECTION PLAT

_____ Ft. from N. Line

100 _____ Ft. from S. Line

100 _____ Ft. from E. Line

_____ Ft. from W. Line

Seward County

Location X

Rig up

Drilling and Remarks:

RECORD

Cased _____ in., _____ ft.

Sand _____

Gas _____

Oil _____

Total Depth _____

PRODUCTION

1st 24 hrs. Nat. _____

1st 24 hrs. after shot. _____

Gas _____ Cu. Ft.

Dry Hole _____

Abandoned _____

Date

MAY 25 1949

19

S. J. LEWIS

Scout

Map No. ✓ Sec. 18 Twp. 33 R. 34W

Well No. 1 Marteney

Panhandle Eastern Company


COMPLETE

SE NW

Contractor

E12827

SECTION PLAT

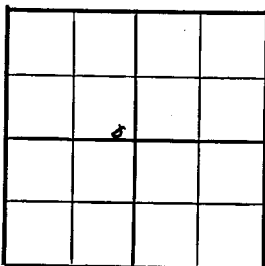

 Ft. from N. Line

100 Ft. from S. Line

100 Ft. from E. Line

 Ft. from W. Line

Seward County

RECORD

Location

Cased in., ft.

Rig up

Sand

Drilling and Remarks:

Gas

7" C2076

Oil

160' of 5" Pipe in hole

Total Depth 2250

C2250

PRODUCTION

1,371,000 lbs

1st 24 hrs. Nat.

705' N.E.

1st 24 hrs. after shot

Gas Cu. Ft.

Dry Hole

Abandoned

Date

JUL 20 1949

19

S. J. LEWIS

Scout