

KANSAS


Comanche

FORM 51 5M 10-41 PETROL

Section 27 Township 33 Range 19-W

Well No. #1 Exchange Bank

Company Sinclair-Prairie

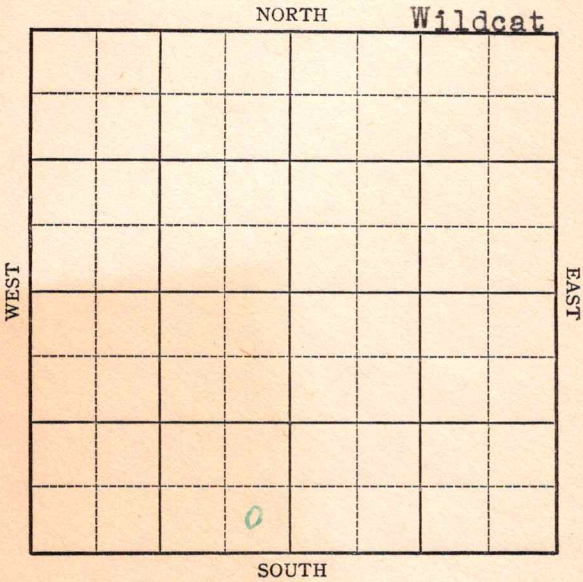

Sec. 27 Twp. 33 R. 19-W

Well No. #1 Exchange Bank Farm

Sinclair-Prairie Company


(Wildcat)

_____ Ft. from N. Line

330 Ft. from S. Line

330 Ft. from E. Line

_____ Ft. from W. Line

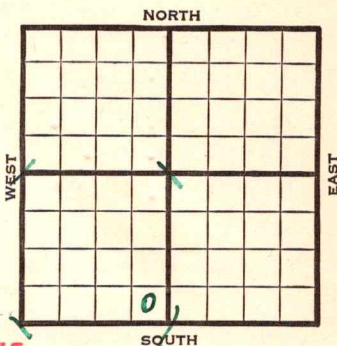

Elev. 1935

1942	REPORT
1/7	Location
1/15	"
1/22	"
1/29	"
2/5	Derrick.
2/12	"
2/19	235' lost circulation.
2/26	13" - 451' WOC.
3/5	Drlg. 2390'
3/12	Drlg. 3300'
3/19	Blaine 245' Anhy. 950'
	Herrington 2500' Ft. Riley 2575'
	B. Florence 2700' Topeka 2610'
	K.C. 4340' Drlg. 4660'
3/26	Drlg. 5225'
4/2	Miss. 5280' Drlg. 5535' Very small show gas.
4/8	Drlg. 5744' in Miss.
4/15	Drlg. 5868'
4/22	Drlg. 6013'
4/29	Drlg. 6098'
	OVER

1942
5/6

Viola 6102'
Drlg. 6169'

5/13 T.D. 6290' SD.

5/20 Drlg. 6305'

5/27 Simp. Dolo. 6351'
Simp. sh. 6384' Simp. sand 6438'
Drlg. 6451'

6/3

Arb. 6462'
T.D. 6525'
No shows.

ABANDONED

Comanche

KANSAS

Map No. 95 Sec. 27 Twp. 33 R. 19W

Well No. 1 Exchange Bank

Sinclair - Prairie Company

FIRST REPORTS Contractor

SE SW


SECTION PLAT

_____ Ft. from N. Line

330 Ft. from S. Line

330 Ft. from E. Line

_____ Ft. from W. Line

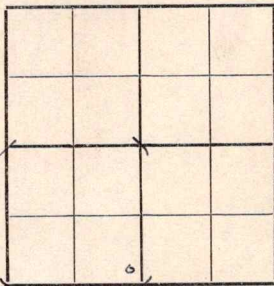

WILDCAT

RECORD

Location XX

Cased _____ in., _____ ft.

Rig up _____

Sand _____

Drilling and Remarks:

Gas _____

Oil _____

Total Depth _____

PRODUCTION

1st 24 hrs. Nat. _____

1st 24 hrs. after shot _____

Gas _____ Cu. Ft.

Dry Hole _____

Abandoned _____

Date

JAN 7 1942 19

S. J. LEWIS Scout

KANSAS

Comanche

Map No. 95 Sec. 27 Twp. 33 R. 19W

Well No. 1 Exchange Bank

Sinclair-Prairie Company

ABANDONED Contractor

SE SW

SECTION PLAT

_____ Ft. from N. Line

330 Ft. from S. Line

330 Ft. from E. Line

_____ Ft. from W. Line

WILDCAT

RECORD

Location _____

Cased _____ in., _____ ft.

Rig up _____

Sand _____

Drilling and Remarks:

Gas _____

Cor 86462

Oil _____

Noshore

Total Depth 6525

PRODUCTION

1st 24 hrs. Nat. _____

1st 24 hrs. after shot _____

Gas _____ Cu. Ft.

Dry Hole _____

Abandoned _____

Date

JUN 3 1942 19

S. J. LEWIS Scout