


Map No. KANSAS Sec. 19 Twp. 33 R. 36^w

Well No. 1 - Paden Farm
Travis Prod Company

 Ft. from N. Line
1320 Ft. from S. Line
1320 Ft. from E. Line
1931 Ft. from W. Line

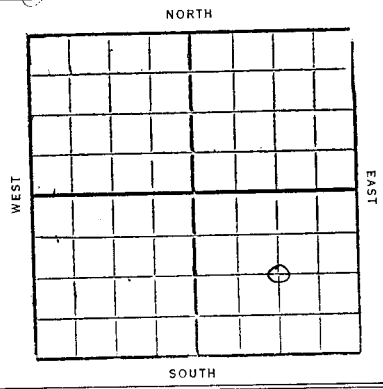

Date

REPORT

8/5	Loc
8/12	Reg
8/19	—
8/26	—
9/2	Spdg
9/9	—
9/16	Em 8" - 2470' Rust
9/23	—
9/30	Cased 8" - 2470'
	Gas 2010 - 2837'
	757.2837'
	5,557,000 cu ft gas
	5 Em 8"

Stevens

Map No. KANSAS Sec. 19 Twp. 33 R. 36 ^W

Well No. 1

Argus Prod Co Company

Contractor

COMPLETED

SECTION PLAT

..... Ft. from N. Line

1320 Ft. from S. Line

1320 Ft. from E. Line

..... Ft. from W. Line

Location.....

Rig up.....

Drilling and Remarks:.....

RECORD

Cased 8 in., 2470 ft.

Sand.....

Gas 2610-2837

Oil.....

Total Depth 2837

PRODUCTION

1st 24 hrs. Nat.

1st 24 hrs. after shot.....

Gas 5,557,000 Cu. Ft.

Dry Hole.....

Abandoned.....

Date

SEP 30 1931

CHAS. L. SHERWOOD

192.....

Scout

Stevens

Map No. KANSAS Sec. 19 Twp. 33 R. 36^W

Well No. 1

Paden

Argus Prod Co Company

Contractor

FIRST REPORTS

SECTION PLAT

..... Ft. from N. Line
1320 Ft. from S. Line
1320 Ft. from E. Line
..... Ft. from W. Line

Location ✓
Rig up
Drilling and Remarks:

RECORD

Cased..... in., ft.
Sand.....
Gas.....
Oil.....
Total Depth.....

PRODUCTION

1st 24 hrs. Nat.....
1st 24 hrs. after shot.....
Gas..... Cu. Ft.
Dry Hole.....
Abandoned.....

Date
AUG 5 1931

192 CHAS. L. SHERWOOD Scout