

KANSAS


Stevens

Form 51-5M-4-36-Palace

Section 19 Township 33 Range 38W

Well Number #1-19 Bain

Company Texas Inter-State Pipe Line.

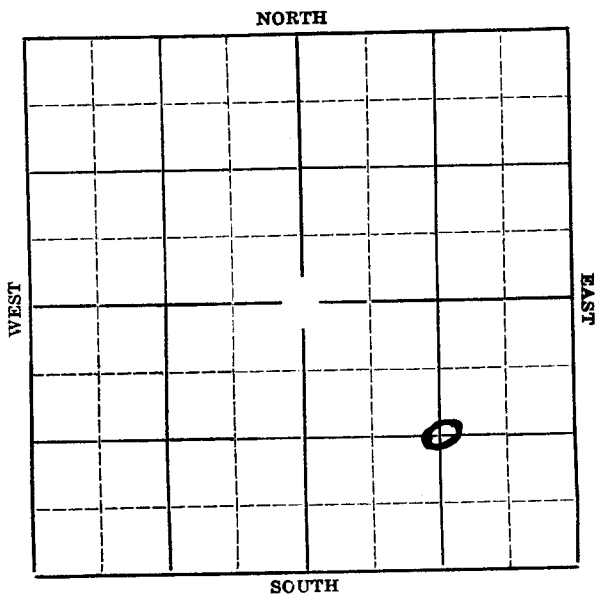

Map No. KANSAS Sec. 19 Twp. 33 R. 38W

Well No. #1-19 Bain Farm


Texas Inter-State P. L. Company

 Ft. from N. Line

1320' Ft. from S. Line

1320' Ft. from E. Line

 Ft. from W. Line

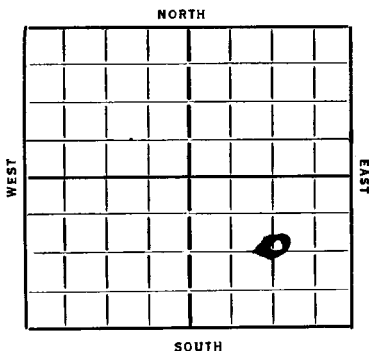

Date 1936 REPORT

5/20 Location

5/28 -- 6/4--6/11--6/18--

6/25 Rigging up.

7/2 Drlg. 705'.

7/9 No report.

7/16 6" @ 2497'. Rigging up st'd tools

7/23--7/30--8/6--8/13--8/20--

8/26/36-Gas sand 2516'.

T.D. 2777'.


3-3/10 million cuft of gas.

COMPLETED

Map No. W Map Sec. 19 Twp. 39 R. 28WWell No. 1-19 BainTexas Interstate Pipe Line Company

Contractor

SECTION PLAT

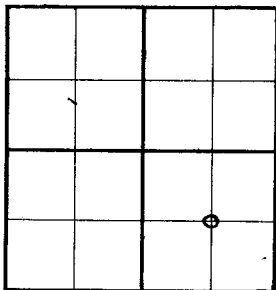

_____ Ft. from N. Line

1320 Ft. from S. Line1320 Ft. from E. Line

_____ Ft. from W. Line

FIRST REPORT

Location ✓

Rig up _____

Drilling and Remarks:

RECORD

Cased _____ in., _____ ft.

Sand _____

Gas _____

Oil _____

Total Depth _____

PRODUCTION

1st 24 hrs. Nat. _____

1st 24 hrs. after shot _____

Gas _____ Cu. Ft.

Dry Hole _____

Abandoned _____

Date

JAN 10 1936 19

S. J. LEWIS Scout


Stevens
 Map No. *NM* Sec. *19* Twp. *33* R. *38W*

Well No. *1-19 Bain*

Texas Inter State P. Co. Company

Contractor

SECTION PLAT

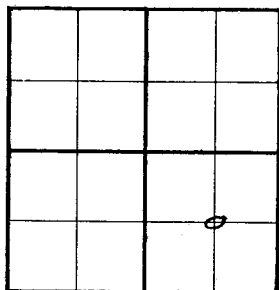

_____ Ft. from N. Line

1320 Ft. from S. Line

1320 Ft. from E. Line

_____ Ft. from W. Line

COMPLETED

Location _____

Rig up _____

Drilling and Remarks:

Gas Sand
2516.
3 3/4 M Gas

RECORD

Cased _____ in., _____ ft.

Sand _____

Gas _____

Oil _____

Total Depth *2777*

PRODUCTION

1st 24 hrs. Nat. _____

1st 24 hrs. after shot _____

Gas _____ Cu. Ft.

Dry Hole _____

Abandoned _____

Date

AUG 26 1930

S. J. LEWIS Scout