


Section 19 Township 33 Range 33W

Well No. #1 Sally

Company Cabot Carbon

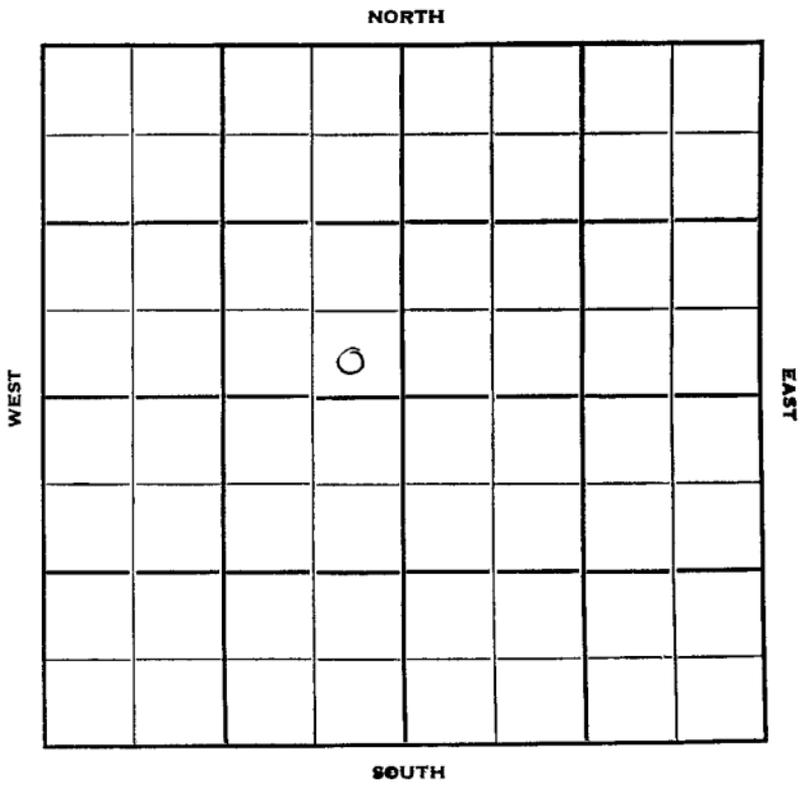

Sec. 19 Twp. 33 R. 33-W

Well No. #1 Sally Farm

Cabot Carbon Company

Contractor

Hugoton


\_\_\_\_\_ Ft. from N. Line

330 Ft. from S. Line

330 Ft. from E. Line

\_\_\_\_\_ Ft. from W. Line

SE SE NW

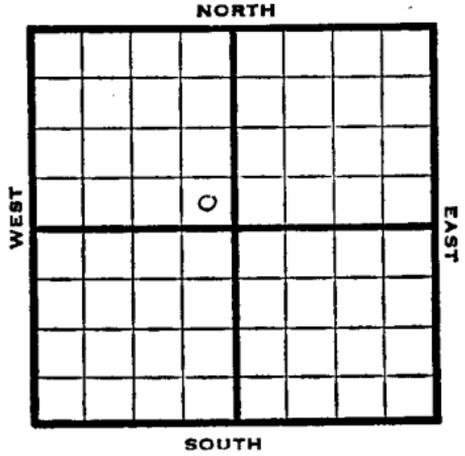

1950 Elev. 2882' REPORT

11/1 8" @ 600

1951  
3/14 Gas well TD 2697'  
8" @ 600, Her. 2620'  
7" @ 2621, Kr. 2650,  
TD 2697' 15,000 A  
Comp. 10,500,000 gas

COMPLETED



