

19-335.3W

STATE OF KANSAS  
STATE CORPORATION COMMISSION

Give All Information Completely  
Make Required Affidavit  
Mail or Deliver Report to:  
Conservation Division  
State Corporation Commission  
800 Biting Building  
Wichita, Kansas

Best Scanned Copy

WELL PLUGGING RECORD

Sumner

County, Sec. 19 Twp. 33S Rge. (E) 3 (W)

Location as "NE/CNW/SW" or footage from lines NW NW SE

Lease Owner O. A. Sutton

Lease Name Hoover Well No. 1

Office Address 407 Insurance Bldg., Wichita, Kans.

Character of Well (completed as Oil, Gas or Dry Hole) Dry Hole

Date well completed December 29 19 59

Application for plugging filed December 29 19 59

Application for plugging approved December 29 19 59

Plugging commenced December 29 19 59

Plugging completed December 29 19 59

Reason for abandonment of well or producing formation Dry Hole


If a producing well is abandoned, date of last production 19

Was permission obtained from the Conservation Division or its agents before plugging was commenced? Yes

Name of Conservation Agent who supervised plugging of this well Lee Guthrie, Leon, Kansas

Producing formation Depth to top Bottom Total Depth of Well 4613 Feet

Show depth and thickness of all well formations

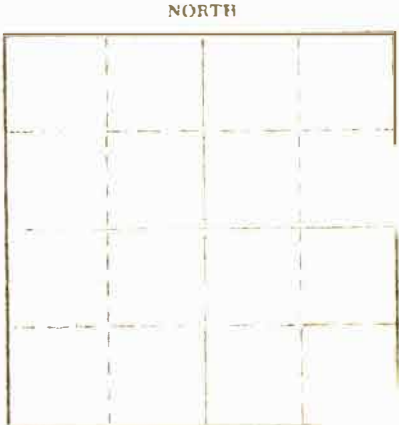

Locate well correctly on this Section Plan

OIL, GAS OR WATER RESERVOIR

CASING RECORD

FORMATION	FEET	FROM	TO	SIZE	PUT IN	PULLED OUT
				8-5/8"	220'	None

OWELL

Describe in detail the manner in which the well was plugged, indicating where the mud fluid was placed and the method or methods used in introducing it into the hole. If cement or other plugs were used, state the character of same and depth placed, from feet to feet for each plug set.

Plugged hole from 4613 up to 225. Set plug #1 at 225, mixed 1/4 sx. Hulls and 15 sx. cement. Filled with mud from 180 up to 35'. Set plug #2 at 35' - mixed 1/4th sx hulls and 10 sx. cement.

(If additional description is necessary, use BACK of this sheet)

Name of Plugging Contractor O. S. Sutton & Sons Drilling Co.

Address 315 Insurance Bldg., Wichita, Kansas

STATE OF KANSAS COUNTY OF SALGEMAN R. G. Brooke

Employee of owner or ~~XXXXXXX~~ of the above-described well, being first duly sworn on oath, says: That I have knowledge of the facts, statements, and matters herein contained and the log of the above described well as filed and that the same are true and correct. So help me God.

(Signature) R. G. Brooke

407 Insurance Bldg., Wichita, Kansas

December 19 59

Hazel Clark Notary Public