Sumner

FORM 51 IOM 12-46 PETROL

KANSAS


Section 12 Township 33 Range 2W

Well No. 1 Dowis

Company Carter Oil

Misc.

11

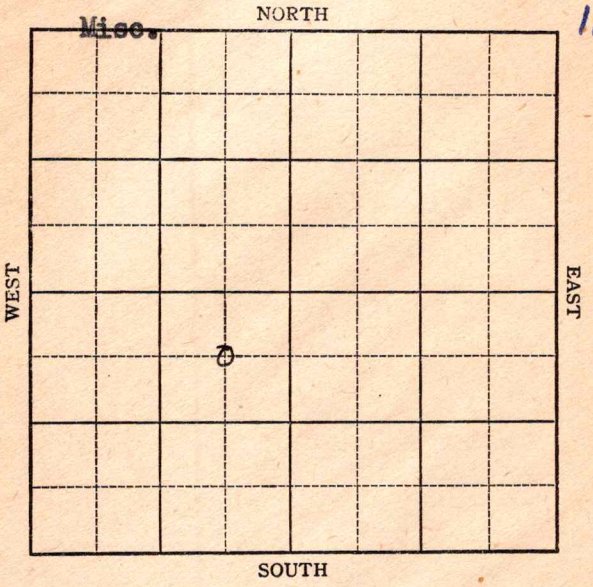

FORM 252-A
5M 12-46 PETROL

KANSAS

Summer

Sec. 12 Twp. 33 R. 2-W

Well No. #1 Dowis Farm

Carter Oil Company

Miscellaneous


660 Ft. from N. Line

Ft. from S. Line

660 Ft. from E. Line

Ft. from W. Line

C NE SW

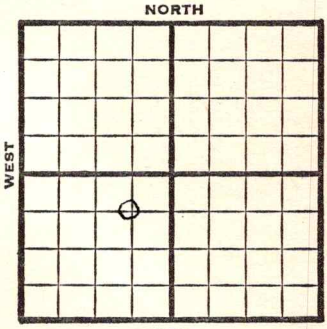

REPORT

1947	Elev. 1229'
4/30	Location
5/7	10" @ 591' Drlg. 1245'
5/13	Drlg 3000'
5/20	Miss 3878' Drlg 3949'
5/27	Simpson 4241 TD 4242 7" @ 4241 RUST
6/3	TD 4244 Flow.
6/10	" "
6/17	Flow483 bbls. oil in 8½ hrs.
6/24	" " "
7/2	Simp. 4241' 7" @ 4241' Bonus Pot 3000 37.5 Gr. TD 4244' COMPLETED

4241
1229
3012

Form 26 200 Bks. 10-46 Petrol KANSAS Miscellaneous

Kansas

Map No. K31 Sec. 12 Twp. 33 R. 2W

Well No. 1 Dowis

Carter Oil Company

FIRST REPORT Contractor

C NE SW


660 Ft. from N. Line

____ Ft. from S. Line

660 Ft. from E. Line

____ Ft. from W. Line

SECTION PLAT

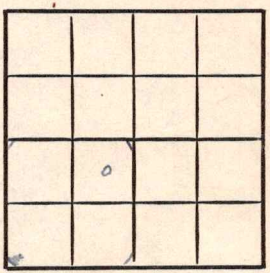

Sumner County

Location x

Rig up

Drilling and Remarks:

RECORD

Cased ____ in., ____ ft.

Sand

Gas

Oil

Total Depth

PRODUCTION

1st 24 hrs. Nat.

1st 24 hrs. after shot

Gas ____ Cu. Ft.

Dry Hole

Abandoned

Date

APR 30 1947 19 S. J. LEWIS Scout

Form 26 200 Bks. 10-46 Petrol

Miscellaneous

Kansas

Map No. 31 Sec. 12 Twp. 33 R. 2W

Well No. 1 Dowis


Carter Oil Company

COMPLETE Contractor

C NE SW

LT 1,1228

SECTION PLAT

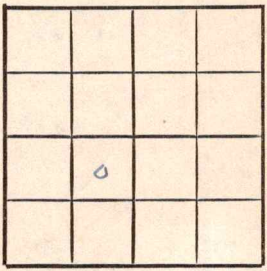

660 Ft. from N. Line

Ft. from S. Line

660 Ft. from E. Line

Ft. from W. Line

Sumner County

Location

Rig up

Drilling and Remarks:

Surf 424'

7" @ 4241

Bam 4 BS

8000

47 5 Gr

RECORD

Cased in., ft.

Sand

Gas

Oil

Total Depth 4244

PRODUCTION

1st 24 hrs. Nat.

1st 24 hrs. after shot

Gas Cu. Ft.

Dry Hole

Abandoned

Date

JUL 2 1947 19

S. J. LEWIS Scout