


Section 12 Township 33 Range 2W

Well No. 2 Dowis

Company Carter

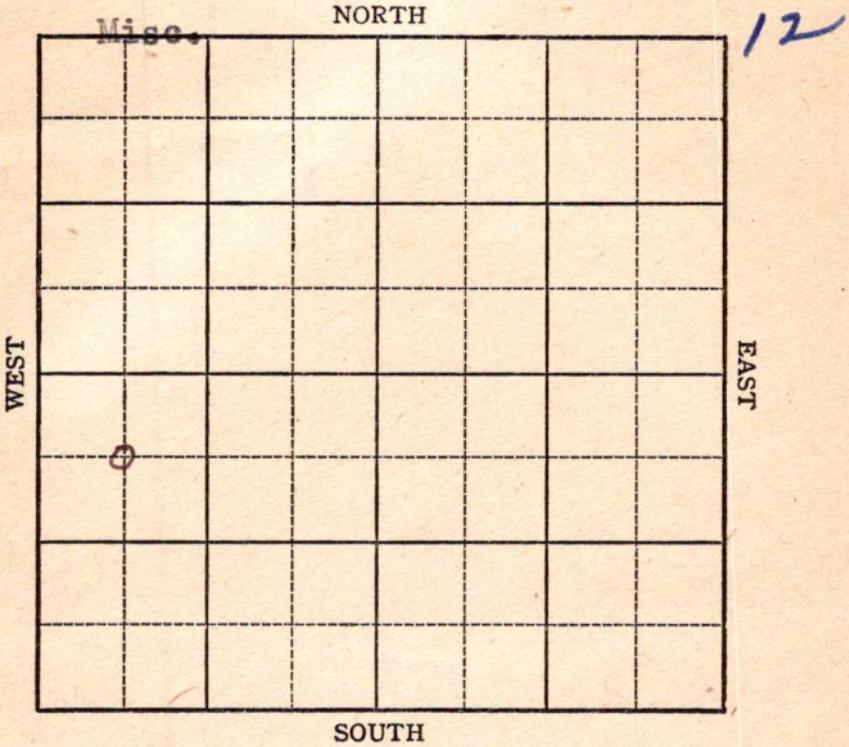

Sec. 12 Twp. 33 R. 2W

Well No. #2 Dowis Farm

Carter Company

Misc.


660 Ft. from N. Line

_____ Ft. from S. Line

_____ Ft. from E. Line

660 Ft. from W. Line

C NW SW

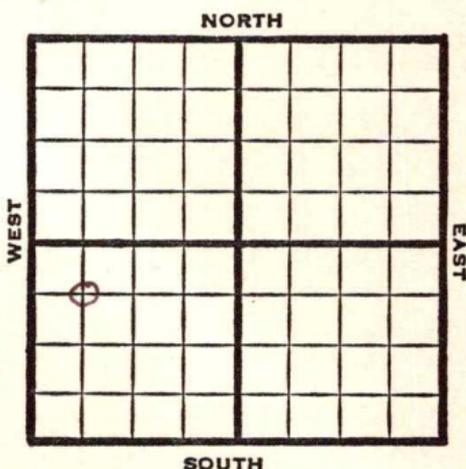

1947

E₁ ev. 1220' REPORT

7/23

Location

7/29

"

8/6

RUR

4233
1220

3013

8/13

8" @ 535'
Drlg. 1492'

8/20

Drlg 3455'

8/27

Simpson 4233'

4238' TD

Run 5"

9/3

5" @ 4231'

9/10

"

9/17

Flow 16 bbls. oil PH 18 hrs.

9/24

Simp. 4233'

5" @ 4231'

Bonus Pot 1839'

44.0 Gr.

TD 4236'

COMPLETED

Kans

Map No. _____ Sec. 12 Twp. 33 R. 2W

Well No. 2 Dowis

Carter Company

FIRST REPORT Contractor

C NW SW

SECTION PLAT

660 Ft. from N. Line

_____ Ft. from S. Line

_____ Ft. from E. Line

660 Ft. from W. Line

Sumner County

Location X

Rig up _____

Drilling and Remarks:

RECORD

Cased _____ in., _____ ft.

Sand _____

Gas _____

Oil _____

Total Depth _____

PRODUCTION

1st 24 hrs. Nat. _____

1st 24 hrs. after shot _____

Gas _____ Cu. Ft.

Dry Hole _____

Abandoned _____

Date

JUL 23 1947

19

S. J. LEWIS

Scout

Map No. 31 Sec. 12 Twp. 33 R. 2W

Well No. 2 Dowis

Carter Company

COMPLETE

Contractor

C NW SW

E1,1220
SECTION PLAT

660 Ft. from N. Line

_____ Ft. from S. Line

_____ Ft. from E. Line

660 Ft. from W. Line

Sumner County

Location _____

Rig up _____

Drilling and Remarks:

Sump. 4283
5" @ 4281
Bored 8/1/1939

RECORD

Cased _____ in., _____ ft.

Sand _____

Gas _____

Oil _____

Total Depth 4286

PRODUCTION

1st 24 hrs. Nat. _____

1st 24 hrs. after shot _____

Gas _____ Cu. Ft.

Dry Hole _____

Abandoned _____

44289

Date

SEP 24 1947 19

S. J. LEWIS Scout