Sumner

FORM 51 10M 8-47


KANSAS

Section 12 Township 33 Range 2W

Well No. #3 Dowis

Company Carter

13

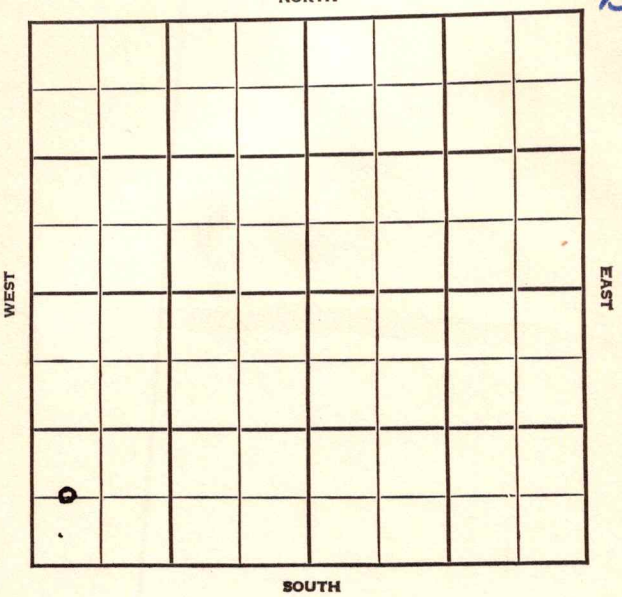

FORM 252-A
5M 9-47 PETROL


Sumner KANSAS ✓

Sec. 12 Twp. 33 R. 2W

Well No. #3 Dowis Farm

Carter Company

Misc.

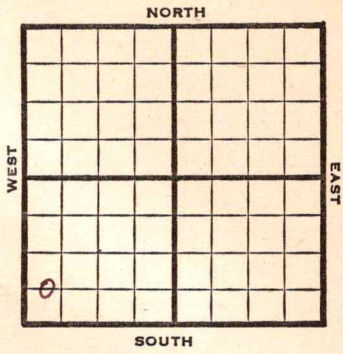

Ft. from N. Line

660 Ft. from S. Line

Ft. from E. Line

330 Ft. from W. Line

C W L SW SW

1948	Elev. 1227' REPORT
1/28	Location
2/4	Drlg. 250'
2/11	10" @ 536' Drlg. 1455'
2/18	Drlg 3525'
2/25	3880' SG
3/3	KC 3235' Miss. 3912' Drlg. 3920'
3/10	Simpson Sand 4249' TD 4252' SD Run csg.
3/17	5" @ 4251' RUST
3/24	TD 4253' Flow 75 bbls oil 4 hrs.
3/31	Swb 100 bbls fluid 12 hrs. 8% oil
4/7	"
4/14	"
4/21	"

OVER

1948

4/28 Simp 4249'
5" @ 4251'
Pump 50 oil & 230 W Pot.
Gr. 45°
TD 4253'

COMPLETED

Form 26 200 Bks. 10-46 Petrol

Miscellaneous

Kansas

Map No. _____ Sec. 12 Twp. 33 R. 2 W


Well No. 3 Dowis

Carter Company

IRST REPORT Contractor

C W L SW SW

SECTION PLAT

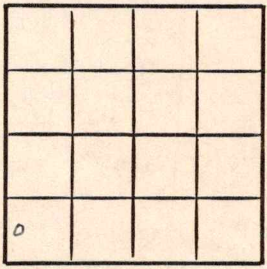

_____ Ft. from N. Line

660 Ft. from S. Line

_____ Ft. from E. Line

330 Ft. from W. Line

Sumner County

Location X

Rig up _____

Drilling and Remarks:

RECORD

Cased _____ in., _____ ft.

Sand _____

Gas _____

Oil _____

Total Depth _____

PRODUCTION

1st 24 hrs. Nat. _____

1st 24 hrs. after shot _____

Gas _____ Cu. Ft.

Dry Hole _____

Abandoned _____

Date

JAN 28 1948 19

S. J. LEWIS Scout

Form 26—200 Bks.—1-48—Palace

Kansas

Miscellaneous

Map No. 31 Sec. 12 Twp. 33 R. 2W

Well No. 3 Dowis


Carter Company

COMPLETE Contractor

C W L SW SW

Elev 1227

SECTION PLAT

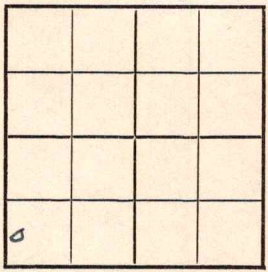

____ Ft. from N. Line

660 Ft. from S. Line

____ Ft. from E. Line

330 Ft. from W. Line

Sumner County

Location

Rig up

Drilling and Remarks:

Samp 4249

5" @ 4251

Pump 50 oil +

280 W/Bail

4522 Gr

RECORD

Cased ____ in., ____ ft.

Sand

Gas

Oil

Total Depth 4253

PRODUCTION

1st 24 hrs. Nat.

1st 24 hrs. after shot

Gas ____ Cu. Ft.

Dry Hole

Abandoned

Date

APR 28 1948

19____ S. J. LEWIS Scout