

KANSAS


Sumner county

FORM 51 IOM 12-46 PETROL

Section 12 Township 33 Range 2-W

Well No. #1 Skaggs

Company Falcon-Seaboard

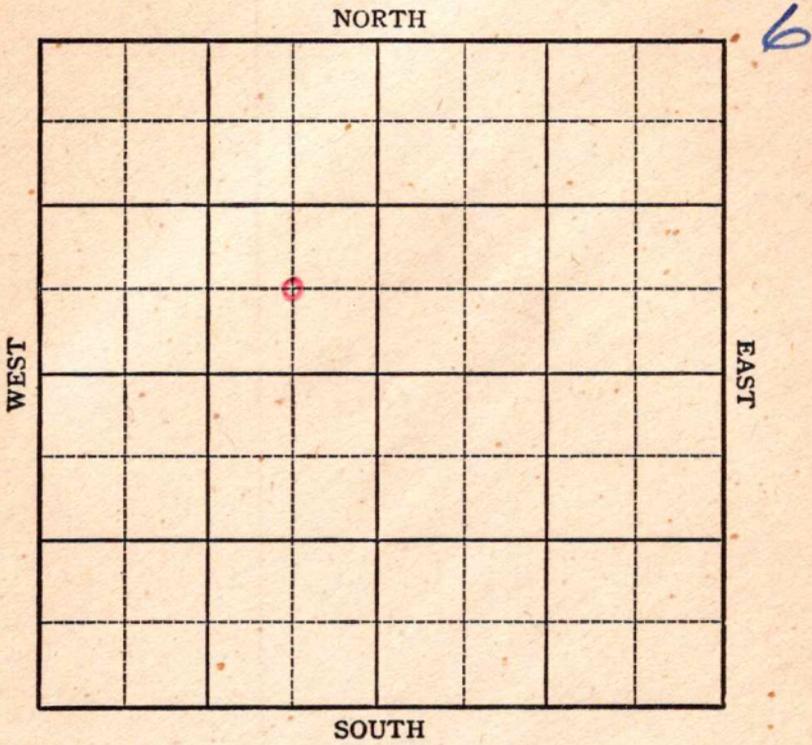


Sec. 12 Twp. 33 R. 2-W

Well No. #1 Skaggs Farm _____
Falcon-Seaboard Company _____

Miscellaneous

_____ Ft. from N. Line
660 Ft. from S. Line
660 Ft. from E. Line
 _____ Ft. from W. Line

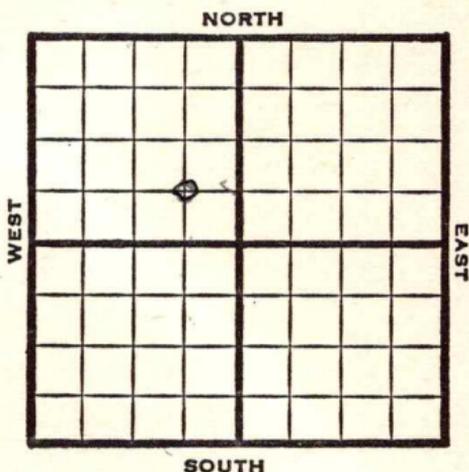

C SE NW

REPORT

1947 **1233**

2/5	Location		
2/12	Drlg 1850'		
2/19	Drlg 3450'		
2/26	8" @ 590' Drlg 4150'		
3/4	Miss 3867' Simp 4242' TD 4246' 5" @ 4246' RUST		
3/11	Flow 198 bbls oil in 3½ hrs		
3/18	Flow 18 bbls PH 2 hrs		
3/25	Flow 860 bbls oil in 24 hrs		
4/2	Flow 140 bbls. oil in 24 hrs. thru 13/64 choke.		
4/9	"	"	"
4/15	"	"	"
4/23	"	"	"
4/29	"	"	"
5/7	"	"	"

OVER

5/14

Simp. 4242'

5" @ 4246'

Bone & Pot 1578'

48.0 Gr.

TD 4247'

COMPLETED

Map No. 31 Sec. 12 Twp. 33 R. 2W

Well No. 1 Skaggs

Falcon-Seaboard Company

FIRST REPORT

Contractor

C SE NW


SECTION PLAT

 Ft. from N. Line

660 Ft. from S. Line

660 Ft. from E. Line

 Ft. from W. Line

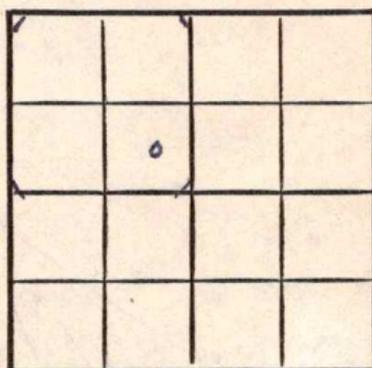

Sumner County

Location X

Rig up

Drilling and Remarks:

RECORD

Cased in., ft.

Sand

Gas

Oil

Total Depth

PRODUCTION

1st 24 hrs. Nat.

1st 24 hrs. after shot

Gas Cu. Ft.

Dry Hole

Abandoned

Date

FEB 5 1947 19

S. J. LEWIS Scout

Kansas

Miscellaneous

Map No. K31 Sec. 12 Twp. 33 R. 2W

Well No. 1 Skaggs

Falcon-Seaboard Company

COMPLETE

Contractor

C SE NW

E 1/2 29
SECTION PLAT

_____ Ft. from N. Line

660 Ft. from S. Line

660 Ft. from E. Line

_____ Ft. from W. Line

	o		

Sumner County

Location _____

Rig up _____

Drilling and Remarks:

Sing 4242
5" @ 4246
Box 4241578
452 42

RECORD

Cased _____ in., _____ ft.

Sand _____

Gas _____

Oil _____

Total Depth 4247

PRODUCTION

1st 24 hrs. Nat. _____

1st 24 hrs. after shot _____

Gas _____ Cu. Ft.

Dry Hole _____

Abandoned _____

Date

MAY 14 1947 19

S. J. LEWIS

Scout