

Section 1 Township 33 Range 2 W

Well No. # 1 Blue

Company E. F. Wakefield, et al

NORTH

//

			0				

WEST

EAST

SOUTH

Sumner

KANSAS ✓

Sec. 1 Twp. 33 R. 2W

Well No. #1 Blue Farm

E. F. Wakefield et al Company


Wakefield Contractor
Wildcat

330 Ft. from N. Line

Ft. from S. Line

330 Ft. from E. Line

Ft. from W. Line

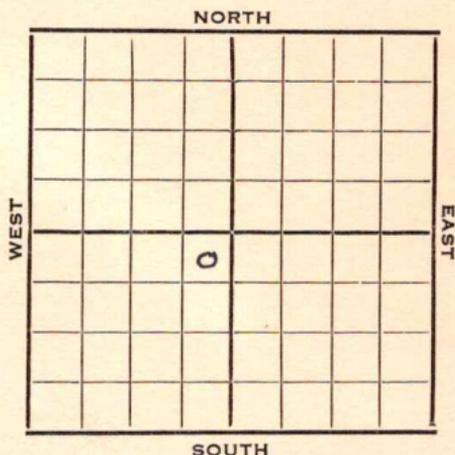

NE NE SW
Carter Acreage & DHM

1952 Elev. 1240' REPORT

8/20 Location

8/27 "

9/3 8" @ 125
Stal 2915
KC 3208
Drlg. 3358

9/10 Osw 3544 Miss 3876 Drlg. 4186

9/17 Spud 8-25-52
D & A TD 4298' 8" @ 125
Stal. 2915' KC 3208' Oswego 3544'
Miss 3876' Simp. 4295'
TD 4298' D & A

ABANDONED

