

KANSAS

Miscellaneous


FORM 51 IOM 12-46 PETROL

Sumner county

Section 12 Township 33 Range 2W

Well No. 2 Skaggs

Company Falcon-Seaboard

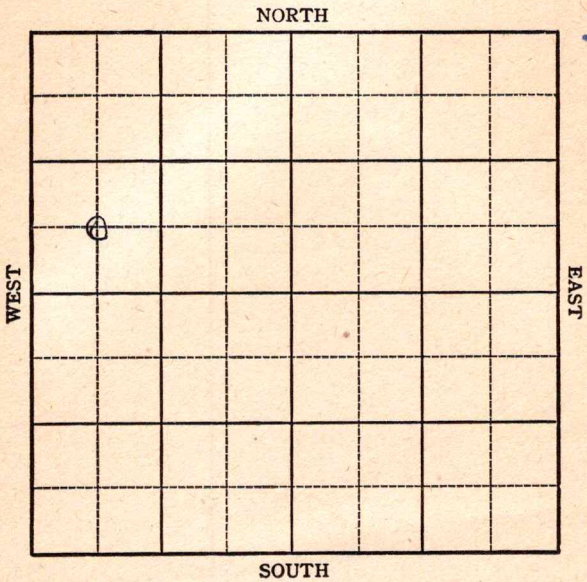

KANSAS

Summer ✓

Sec. 12 Twp. 33 R. 2-W

Well No. #2 Skaggs Farm


Falcon-Seaboard Company
Miscellaneous

 Ft. from N. Line

660 Ft. from S. Line

 Ft. from E. Line

660 Ft. from W. Line

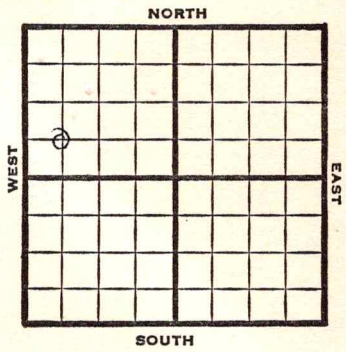

C SW NW

REPORT

1947 **Elev. 1229'**

| | |
|------|--|
| 4/23 | Location |
| 4/29 | " |
| 5/7 | " |
| 5/13 | " |
| 5/20 | " |
| 5/27 | " |
| 6/3 | RUR |
| 6/10 | 8" @ 552' Drlg. 1810' |
| 6/17 | Drlg. 3325' |
| 6/24 | Mississippi 3883' Drlg. 3897' |
| 7/1 | Simpson Sand 4241-45 TD Run 5' |
| 7/8 | 5" @ 4241' RUST |
| 7/16 | TD 4246' Flo 283' bbls oil 4 hrs. |

OVER

1947

7/22 TD 4246
Flow 283 bbls. oil 4 hrs.

7/30 **Simp. 4241'**
5" @ 4241'
Bonus Pot. 1559'
Gr. 46.0
TD 4246'

COMPLETED

KANSAS

Kansas

Map No. 1531 Sec. 12 Twp. 33 R. 2W

Well No. 2 Skaggs

Falcon-Seaboard Company

FIRST REPORT Contractor

C SW NW

SECTION PLAT

 Ft. from N. Line

660 Ft. from S. Line

 Ft. from E. Line

660 Ft. from W. Line

| | | | |
|---|--|--|--|
| | | | |
| o | | | |
| | | | |
| | | | |

Sumner County

Location X

Rig up

Drilling and Remarks:

RECORD

Cased in., ft.

Sand

Gas

Oil

Total Depth

PRODUCTION

1st 24 hrs. Nat.

1st 24 hrs. after shot

Gas Cu. Ft.

Dry Hole

Abandoned

Date

APR 23 1947 19

S. J. LEWIS Scout

Map No. 31 Sec. 12 Twp. 33 R. 2W

Well No. 2 Skaggs

Falcon-Seaboard Company

COMPLETE

Contractor

C SW NW

E 1/2 29
SECTION PLAT

 Ft. from N. Line

660 Ft. from S. Line

 Ft. from E. Line

660 Ft. from W. Line

| | | | |
|----------|--|--|--|
| | | | |
| <i>8</i> | | | |
| | | | |
| | | | |

Sumner County

Location

Rig up

Drilling and Remarks:

Shelf 4241
5" @ 4241
Bore PT 1559

460 ft

RECORD

Cased in., ft.

Sand

Gas

Oil

Total Depth 4246

PRODUCTION

1st 24 hrs. Nat.

1st 24 hrs. after shot

Gas Cu. Ft.

Dry Hole

Abandoned

Date

JUL 30 1947 19

S. J. LEWIS

Scout