

Summer


FORM 51 IOM 12-46 PETROL

KANSAS

Section 12 Township 33 Range 2W

Well No. 1 Wykoff

Company Falcon-Seaboard

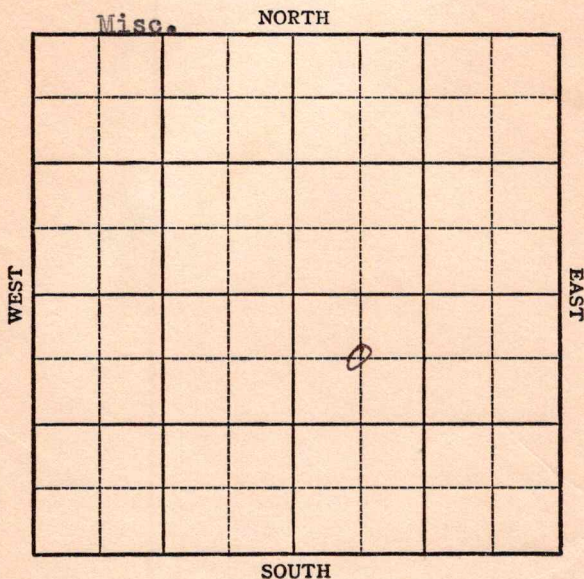

KANSAS

Sumner

Sec. 12 Twp. 33 R. 2-W

Well No. 1 Wykoff Farm

Falcon-Seaboard Company

Miscellaneous


660 Ft. from N. Line

 Ft. from S. Line

 Ft. from E. Line

660 Ft. from W. Line

C NW SE

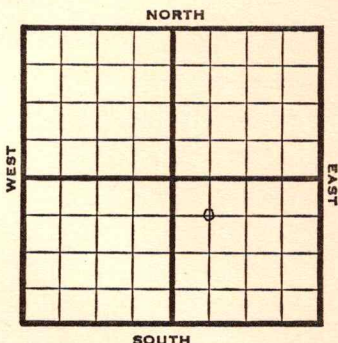

1947	Elev. 1282	REPORT
9/3	Loc.	
9/10	Drlg. 149'	
9/17	8" @ 538' Drlg. 2380'	
9/24	KC 3230' Drlg. 3725'	4249 1282 2967
,10/1	Mississippi 3872 Simpson 4249 TD 4268	
	ABANDONED	

Map No. _____ Sec. 12 Twp. 33 R. 2W

Well No. 1 Wykoff

Falcon-Seaboard

Company

FIRST REPORT

Contractor

C NW SE


SECTION PLAT

660 Ft. from N. Line

_____ Ft. from S. Line

_____ Ft. from E. Line

660 Ft. from W. Line

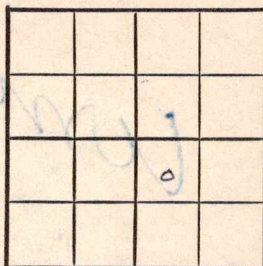

Sumner County

Location X

Rig up _____

Drilling and Remarks:

RECORD

Cased _____ in., _____ ft.

Sand _____

Gas _____

Oil _____

Total Depth _____

PRODUCTION

1st 24 hrs. Nat. _____

1st 24 hrs. after shot _____

Gas _____ Cu. Ft.

Dry Hole _____

Abandoned _____

Date

SEP 3 1947 19

S. J. LEWIS

Scout

Map No. 31 Sec. 12 Twp. 33 R. 2W

Well No. 1 Wykoff

Falcon-Seaboard Company

ABANDONED

Contractor

C NW SE

E 1, 1282

SECTION PLAT

		0	

660 Ft. from N. Line

 Ft. from S. Line

 Ft. from E. Line

660 Ft. from W. Line

Sumner County

Location

Rig up

Drilling and Remarks:

Mis 3872

Temp 4248

RECORD

Cased in., ft.

Sand

Gas

Oil

Total Depth 4268

PRODUCTION

1st 24 hrs. Nat.

1st 24 hrs. after shot

Gas Cu. Ft.

Dry Hole

Abandoned

Date

OCT 1 1947 19

S. J. LEWIS Scout