KANSAS


Stevens

FORM 51 5M 4-41 PETROL

Section 2 Township 33 Range 37-W

Well No. #1 Curry

Company Northern Natural Gas

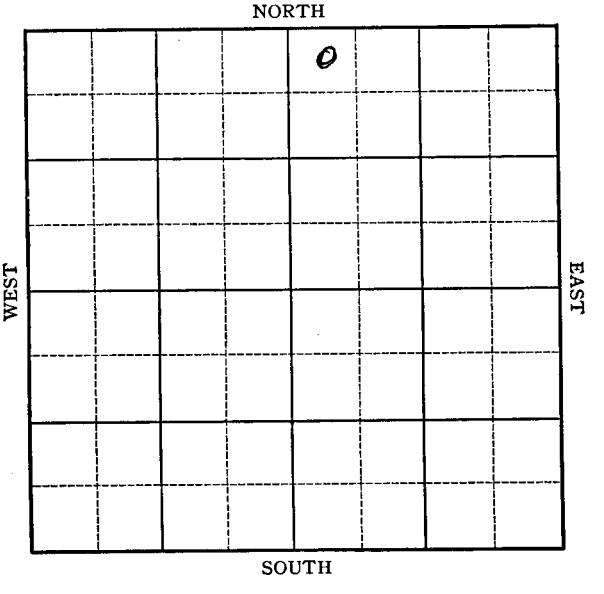

FORM 252-A 5M 1-41 PETROL KANSAS Stevens

Sec. 2 Twp. 33 R. 37-W

Well No. #1 Curry Farm

Northern Natural Gas Company


(Misc.)

330 Ft. from N. Line

_____ Ft. from S. Line

_____ Ft. from E. Line

430 Ft. from W. Line

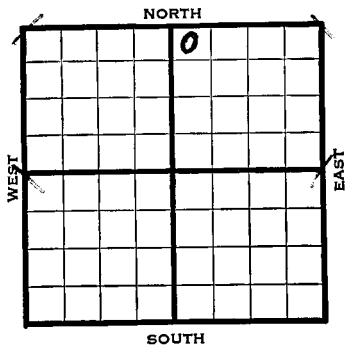

1941	REPORT
6/25	Derrick.
7/3	"
7/10	10" - 611' Drlg. 2463'
7/17	" " "
7/24	7" @ 2665' TD 2840' 10000 acid
	24 M Gas
7/31	" " " " "
8/7	" " " " "
8/13	Florence 2340'
	7" - 2665'
	10,000 acid
	T.D. 2840'
	State Pot. 16,932,000 gas.
	COMPLETED

Form 26 200 Bks. 5-41 McW. Stevens KANSAS

Map No. NW Sec. 2 Twp. 33 R. 37W

Well No. 1 Curry

Northern Natural Gas Company

Contractor

FIRST REPORT

NW NE


330 Ft. from N. Line

Ft. from S. Line

Ft. from E. Line

430 Ft. from W. Line

SECTION PLAT

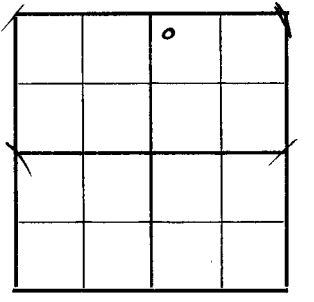

MISCELLANEOUS

Location

Rig up

Drilling and Remarks:

Derrick

RECORD

Cased in., ft.

Sand

Gas

Oil

Total Depth

PRODUCTION

1st 24 hrs. Nat.

1st 24 hrs. after shot

Gas Cu. Ft.

Dry Hole

Abandoned

Date

JUN 25 1941 19

S. J. LEWIS Scout

Form 26 200 Bks. 5-41 McW. KANSAS Stevens

Map No. NM Sec. 2 Twp. 33 R. 37W

Well No. 1 Curry

Northern Natural Gas Company

COMPLETED

Contractor

NW NE

330 Ft. from N. Line


Ft. from S. Line

Ft. from E. Line

430 Ft. from W. Line

MISCELLANEOUS

SECTION PLAT

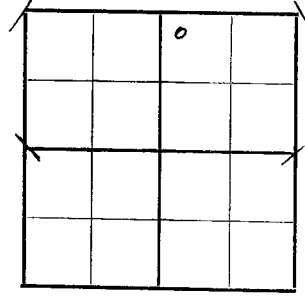

Location

Rig up

Drilling and Remarks:

Florence 2840
7" 26 #
10,000 acid
Stat Pat
16,932,000 Gas

RECORD

Cased in., ft.

Sand

Gas

Oil

Total Depth 2840

PRODUCTION

1st 24 hrs. Nat.

1st 24 hrs. after shot

Gas Cu. Ft.

Dry Hole

Abandoned

Date

19 S. J. LEWIS Scout