Stevens


KANSAS

FORM 51 5M 4-41 PETROL

Section 2 Township 33 Range 37-W

Well No. #2 Madden

Company Northern Natural Gas (Misc.)

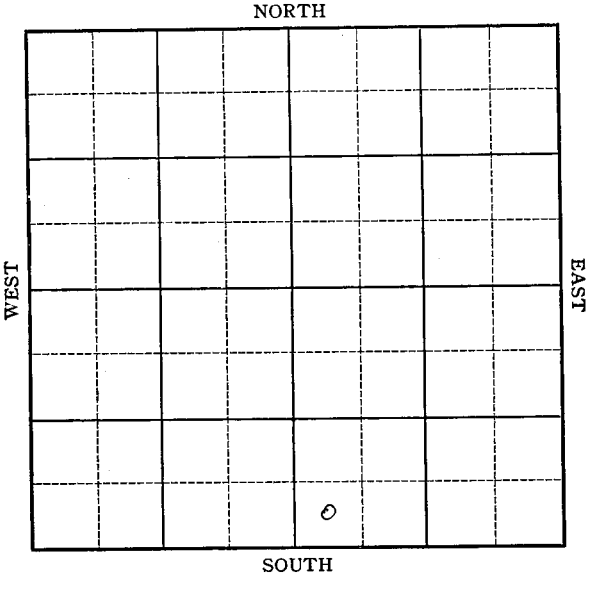

FORM 252-A 5M 6-41 PETROL KANSAS Stevens

Sec. 2 Twp. 33 R. 38-W

Well No. #2 Madden Farm

Northern Natural Gas Company


(Miscellaneous)

Ft. from N. Line

330 Ft. from S. Line

Ft. from E. Line

330 Ft. from W. Line

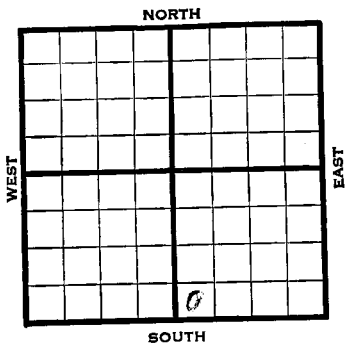

	REPORT
~~1941~~	
7/23	Location
7/31	"
8/7	"
8/15	"
8/21	"
8/28	10" - 560' Drlg. 700'
9/4	" " "
9/11	7" - 2638' T.D. 2819'
	3 M gas. 1000 acid.
9/18	" " " "
9/25	" " " "
10/2	" " " "
10/8	Kri[illegible] 2646'
	7" - 2638'
	T.D. 2819'
	10000 acid.
	25,764,000 cu. ft. gas.
	COMPLETED

Form 26 200 Bks. 5-41 McW. Stevens


Map No. NM Sec. 2 Twp. 33 R. 37W

Well No. 2 Madden

Northern Natural Gas Company

FIRST REPORT Contractor

SECTION PLAT

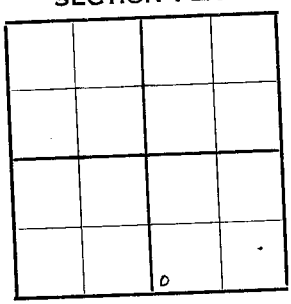

SW SE

Ft. from N. Line

330 Ft. from S. Line

Ft. from E. Line

330 Ft. from W. Line

MISCELLANEOUS

Location X

Rig up

Drilling and Remarks:

RECORD

Cased in., ft.

Sand

Gas

Oil

Total Depth

PRODUCTION

1st 24 hrs. Nat.

1st 24 hrs. after shot

Gas Cu. Ft.

Dry Hole

Abandoned

Date

JUL 23 1941 19 S. J. LEWIS Scout

Form 26 200 Bks. 5-41 McW. Stevens KANSAS

Map No. NW Sec. 2 Twp. 33 R. 37W

Well No. 2 Madden

Northern Natural Gas Company

COMPLETED Contractor

SW SE


Ft. from N. Line

330 Ft. from S. Line

Ft. from E. Line

330 Ft. from W. Line

SECTION PLAT

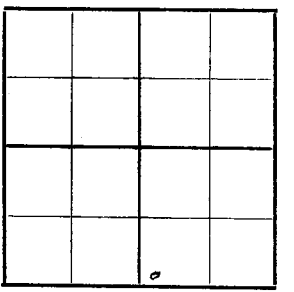

MISCELLANEOUS

Location

Rig up

Drilling and Remarks:

Rec'd 2646

7" @ 2638.

10000 acid

25,764,000 cu ft Gas

RECORD

Cased in., ft.

Sand

Gas

Oil

Total Depth 2819

PRODUCTION

1st 24 hrs. Nat.

1st 24 hrs. after shot

Gas Cu. Ft.

Dry Hole

Abandoned

Date

OCT 8 1941 19 S. J. LEWIS Scout