

KANSAS

Seward


Section 2 Township 33 Range 34W

Well No. 1 Hitch

Company Panhandle Eastern

Hugoton

NORTH

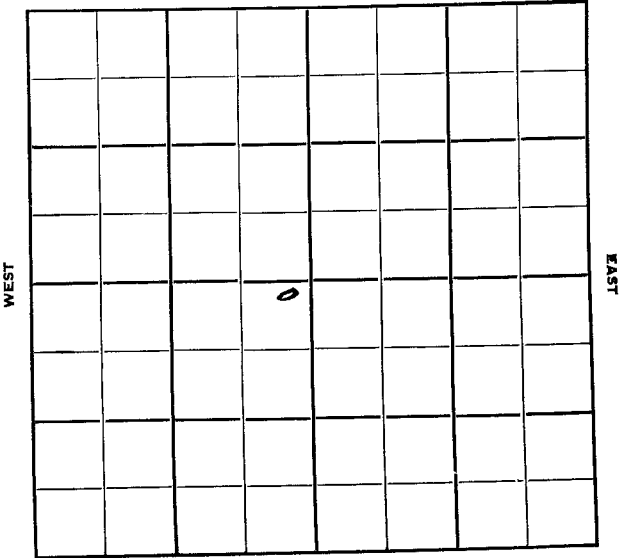

SOUTH

KANSAS

Seward

Sec. 2 Twp. 33 R. ✓ 34W

Well No. #1 Hitch Farm

Panhandle Eastern

Company

Hugoton Pool (Moran, Cont.)


100' Ft. from N. Line

 Ft. from S. Line

100' Ft. from E. Line

 Ft. from W. Line

NE SW

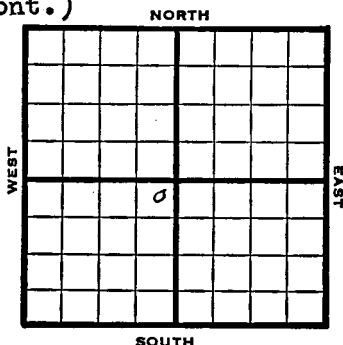

1949

Elev. 2862' REPORT

6/22 Location

6/28 10" @ 481'

7/6 "

7/12 7" @ 2544'

TD 2702'

178 of 5" Perf liner @ 2702

7/20 "

7/27 7" @ 2544'

178' of 5" Perf line @ 2702'

Gas 1,360,000

R. Pr. 412#

TD 2702'

COMPLETED

Map No. _____ Sec. 2 Twp. 33 R. 34W

Well No. 1 Hitch

Panhandle Eastern Company

Moran Contractor

NE SW


FIRST SECTION PLAT

100 Ft. from N. Line

_____ Ft. from S. Line

100 Ft. from E. Line

_____ Ft. from W. Line

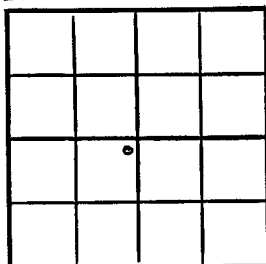

Seward County

Location X

Rig up _____

Drilling and Remarks:

RECORD

Cased _____ in., _____ ft.

Sand _____

Gas _____

Oil _____

Total Depth _____

PRODUCTION

1st 24 hrs. Nat. _____

1st 24 hrs. after shot _____

Gas _____ Cu. Ft.

Dry Hole _____

Abandoned _____

Date

JUN 22 1949 19 S. J. LEWIS Scout

Kansas

Hugoton Pool

Map No. ✓ Sec. 2 Twp. 33 R. 34WWell No. 1 Hitch


Pannandle Eastern

Company

COMPLETE

Contractor

NE SW

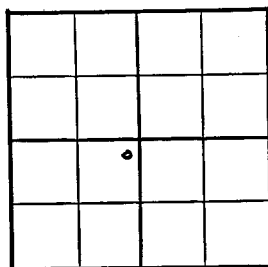E 12862
SECTION PLAT100 Ft. from N. Line Ft. from S. Line100 Ft. from E. Line Ft. from W. Line

Seward County

Location Rig up

Drilling and Remarks:

81102044

1754 5" Key in

C 2702

1,360,000 - see

712 2 1/2

RECORD

Cased in., ft.Sand Gas Oil Total Depth 2702

PRODUCTION

1st 24 hrs. Nat. 1st 24 hrs. after shot Gas Cu. Ft.Dry Hole Abandoned

Date

JUL 27 1949

19

S. J. LEWIS

Scout