


Section 2 Township 33 Range 39-W


Well Number #4 ~~#1~~ Christopher

Company United Prod.

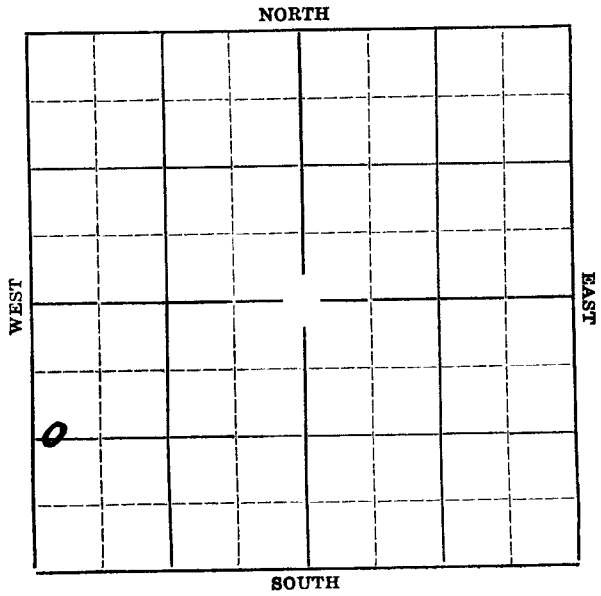

Sec. 2 ~~4~~ Twp. 33 R. 39WWell No. ~~4~~ Christopher FarmUnited Prod. Company Ft. from N. Line1320' Ft. from S. Line Ft. from E. Line140' Ft. from W. Line

Elev. 3216

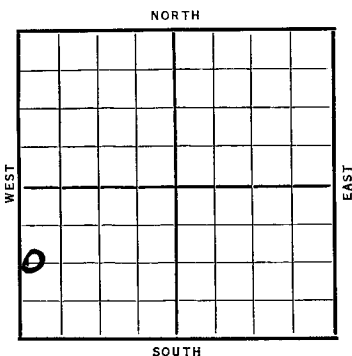

Date	REPORT
10/7	Location.
10/15	--
10/22	10" @ 460'. WOC.
10/29	--
11/6	No report
11/12	Line 2495 7" @ 2497 WOC
11/19	---
1/27	Gas 2510'. Drlg. 2576'.
	7 M Gas.
12/3	No report.
12/10	----
12/16	Gas Sd. 2487'. T. D. 2683'.
	6 M Gas.
	ABANDONED

Clemons

Map No. *No Map* Sec. *2* Twp. *33* R. *39W*

Well No. *1* *Christopher* Farm


United Prod. Company

Date Started _____ Ft. from N. *320* E. *W 140* line

NORTH

WEST

EAST

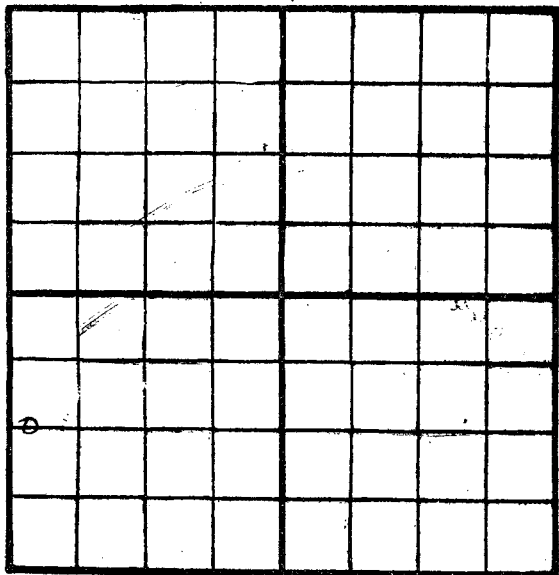

SOUTH

Cased _____ In. _____ Ft.

Sand _____

Pay { Gas _____
Oil _____

Total Depth _____

Production Remarks

Loc

Condition of Well on this date _____

FIRST REPORT

S. J. LEWIS

Scout

Map No. No Maps Sec. 2 Twp. 33 R. 29W

Well No. 4 Christopher

United Prod Company

Contractor

SECTION PLAT

 Ft. from N. Line

1320 Ft. from S. Line

 Ft. from E. Line

140 Ft. from W. Line

CORRECTION

Location

Rig up

Drilling and Remarks:

*Reported as
No. 1*

RECORD

Cased in., ft.

Sand

Gas

Oil

Total Depth

PRODUCTION

1st 24 hrs. Nat.

1st 24 hrs. after shot

Gas Cu. Ft.

Dry Hole

Abandoned

Date

NOV 10 1936 19

S. J. LEWIS

Scout

KANSAS

Map No. No Map Sec. 2 Twp. 33 R. 39Well No. 4 ChristopherUnited Steel Compan

Contracto

SECTION PLAT

_____ Ft. from N. Line

1820 Ft. from S. Line

_____ Ft. from E. Line

170 Ft. from W. Line

COMPLETED

Location _____

Rig up _____

Drilling and Remarks:

Gas Bl 24826 M Gas

RECORD

Cased _____ in., _____ ft

Sand _____

Gas _____

Oil _____

Total Depth 2683

PRODUCTION

1st 24 hrs. Nat. _____

1st 24 hrs. after shot _____

Gas _____ Cu. Ft.

Dry Hole _____

Abandoned _____

Date

DEC 16 1936

19

S. J. LEWIS

Scout