

Form 51-5M-2-29-34703


Map No. *Stevens* *21* *33* *38"*
KANSAS Sec. Twp. R.

Well No. *1-5*

Farm

Texas Interstate Company

NORTH

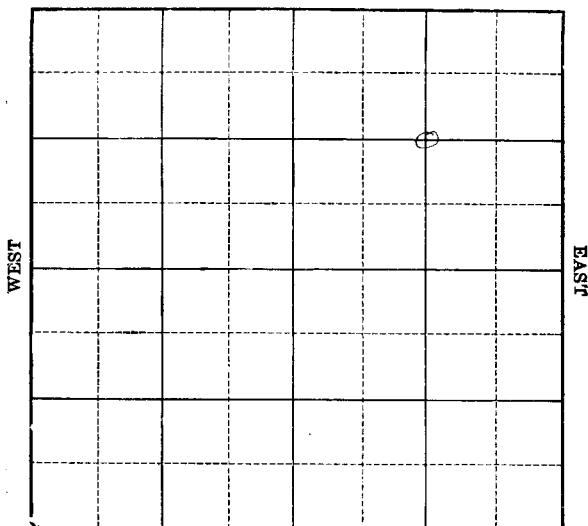

SOUTH

Location

Drilling Remarks

Rig Up

Drilling Remarks

RECORD

Cased _____ in. _____ ft.

Sand _____

Gas _____

Oil _____

Total Depth _____

PRODUCTION

1st 24 hrs. Nat. _____

1st 24 hrs. after shot _____

Gas _____ cu. ft.

Dry Hole _____

Abandoned _____

Map No. KANSAS Sec. 2 Twp. 33 R. 38^w

Well No. 1- Spikes Farm


Texas Interstate Company

1320 Ft. from N. Line

 Ft. from S. Line

1320 Ft. from E. Line

1931 Ft. from W. Line

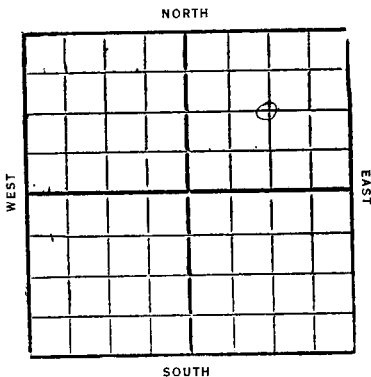

Date	REPORT
4/22	Loc
4/29	—
5/6	—
5/13	—
5/20	—
5/27	—
6/3	—
6/10	—
6/17	—
6/24	—
7/1	Reg
7/8	Sur. pipe 579'
7/15	Drill 2030
7/22	6"-2502'
7/29	TD 2502' Rust
8/5	Gas 2540-2810
	TD 2810
	3,800,000 cu ft gas
	Comp.

Stevens

KANSAS

Map No. _____ Sec. 2 Twp. 33 R. 38 ^WWell No. 1 SpikesTexas Interstate Company

Contractor _____

FIRST REPORTS


1320 Ft. from N. Line

_____ Ft. from S. Line

1320 Ft. from E. Line

_____ Ft. from W. Line

SECTION PLAT

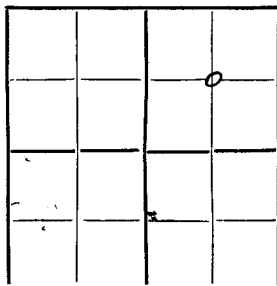Location ✓

Rig up _____

Drilling and Remarks:

RECORD

Cased _____ in., _____ ft.

Sand _____

Gas _____

Oil _____

Total Depth _____

PRODUCTION

1st 24 hrs. Nat. _____

1st 24 hrs. after shot. _____

Gas _____ Cu. Ft.

Dry Hole _____

Abandoned _____

Date

APR 22 1931

CHAS. L. SHERWOOD

192

Scout

*Stevens*Map No. **KANSAS** Sec. *2* Twp. *33* R. *38*^WWell No. *1* *Spikes**Texas Interstate* Company


Contractor

COMPLETE*1320* Ft. from N. Line

Ft. from S. Line

1320 Ft. from E. Line

Ft. from W. Line

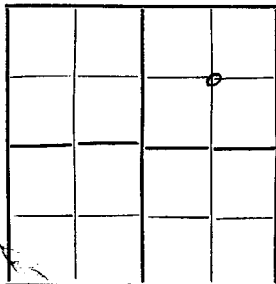SECTION PLAT

Location

Rig up

Drilling and Remarks:

RECORD

Cased in., ft.

Sand

Gas *7540-2810*

Oil

Total Depth *7810***PRODUCTION**

1st 24 hrs. Nat.

1st 24 hrs. after shot

Gas *3,800,000* Cu. Ft.

Dry Hole

Abandoned

Date

AUG 5 *1931* *CHAS. L. SHERWOOD*

192

Scout