

KANSAS

WELL COMPLETION REPORT AND
DRILLER'S LOG

IMPORTANT
Kans. Geo. Survey request
samples on this well.

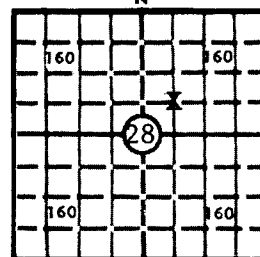
State Geological Survey

WICHITA, BRANCH

S. 28 T.33 R.20 E. W

Loc. SW NE

County Comanche

640 Acres
N

Locate well correctly

Elev.: Gr. 1796'

DF. KB 1803'

API No. 15 — 033 — 20,402
County Number

Operator

K. R. M. Petroleum Corp.

Address

820 Guaranty Bank Bldg. Denver, Colo 80202

Well No.

#1-28

Lease Name

Foster

Footage Location

1980 feet from (N) (E) line 1980 feet from (E) (W) line

Principal Contractor

Xplor Drilling

Geologist

Spud Date

1/21/81

Date Completed

2/1/81 P&A

Total Depth

5265'

P.B.T.D.

Directional Deviation

None

Oil and/or Gas Purchaser

CASING RECORD

Report of all strings set — surface, intermediate, production, etc.

Purpose of string	Size hole drilled	Size casing set (in O.D.)	Weight lbs./ft.	Setting depth	Type cement	Sacks	Type and percent additives
surface	12 1/4"	8-5/8"	24#	765'	C1. "A" Common 50/50 Pozmix	200 200	3% CC 3% CC

LINER RECORD

PERFORATION RECORD

Top, ft.	Bottom, ft.	Sacks cement	Shots per ft.	Size & type	Depth interval

TUBING RECORD

Size	Setting depth	Packer set at

ACID, FRACTURE, SHOT, CEMENT SQUEEZE RECORD

Amount and kind of material used	Depth interval treated

INITIAL PRODUCTION

Date of first production		Producing method (flowing, pumping, gas lift, etc.)			
P & A 2/1/81					
RATE OF PRODUCTION PER 24 HOURS	Oil	Gas	Water	Gas-oil ratio	
	bbls.	MCF		bbls.	CFPB
Disposition of gas (vented, used on lease or sold)			Producing interval (s)		

INSTRUCTIONS: As provided in KCC Rule 82-2-125, within 90 days after completion of a well, one completed copy of this Drillers Log shall be transmitted to the State Geological Survey of Kansas, 4150 Monroe Street, Wichita, Kansas 67209. Copies of this form are available from the Conservation Division, State Corporation Commission, 245 No. Water, Wichita, Kansas 67202. Phone AC 316-522-2206. If confidential custody is desired, please note Rule 82-2-125. Drillers Logs will be on open file in the Oil and Gas Division, State Geological Survey of Kansas, Lawrence, Kansas 66044.

rator

K.R.M. PETROLEUM CORPORATION

DESIGNATE TYPE OF COMP.: OIL, GAS,
DRY HOLE, SWDW, ETC.:
Dry Hole

Well No.

1-28

Lease Name

Foster

S 28 T 33S R 20^{EX}
W

WELL LOG

Show all important zones of porosity and contents thereof; cored intervals, and all drill-stem tests, including depth interval tested, cushion used, time tool open, flowing and shut-in pressures, and recoveries.

SHOW GEOLOGICAL MARKERS, LOGS RUN,
OR OTHER DESCRIPTIVE INFORMATION.

FORMATION DESCRIPTION, CONTENTS, ETC.

TOP

BOTTOM

NAME

DEPTH

DST #1: 4769'-4815' (Swope)

30" IFP=65-68

57" ISIP=998

60" FFP=85-89

117" FSIP=1788

IHP=2479

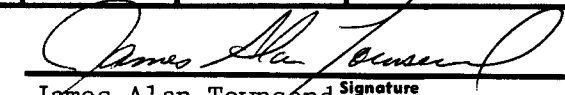
FHP=2407

BHT=118^CRec. 1600' GIP, 60' GCM w/spots of oil,
10' O & GCMRan Dresser Atlas Dual Induction Focused
Log and Densilog Neutron Log.

Cottonwood	2860 (-1056)
Wabaunsee	3380 (-1576)
Heebner Shale	4181 (-2377)
Douglas LS.	4200 (-2397)
Lansing/KC	4374 (-2570)
Stark Shale	4786 (-2982)
Swope LS.	4800 (-2996)
Hush Shale	4822 (-3018)
Base/KC	4879 (-3075)
Marmaton	4922 (-3118)
Ft. Scott LS.	5049 (-3245)
Cherokee	5062 (-3258)
Mississippian	5198 (-3394)
TD	5250 (-3446)

USE ADDITIONAL SHEETS, IF NECESSARY, TO COMPLETE WELL RECORD.

Date Received


James Alan Townsend
Manager of Operations

Signature

Title

2/19/81

Date

State Geological Survey

BRANCH
WICHITA, BRANCHSW NE
28-33-20WOPERATOR: KRM Petroleum Corporation
CONTRACTOR: Xplor Drilling Company, Inc.COMMENCED: January 21, 1981
COMPLETED: February 1, 1981
CASING RECORD: 8 5/8" at 765'#1-28 FOSTER ~~(X)~~

<u>FORMATION</u>	<u>FROM</u>	<u>TO</u>
Red Bed	0	2200
Dolo & Shale	2200	2287
Lime & Shale	2287	2562
Lime & Shale & Dolo	2562	3060
Lime Dolo & Shale	3060	3341
Lime & Shale	3341	5104
Mississippi	5104	5243
Lime & Shale	5243	5265 T.D.

STATE OF KANSAS)

) SS:

COUNTY OF SEDGWICK)

I certify that this is a true and correct copy of the Driller's Log on the well

drilled SW NE Sec. 28-33S-20W, Comanche Co., Kansas

to the best of my

knowledge and belief.