

KANSAS


Stevens county

FORM 51 5M 6-46 PETROL

Section 20 Township 33 Range 37-W

Well No. #1, ~~Barber~~ King

Company McKabb etal

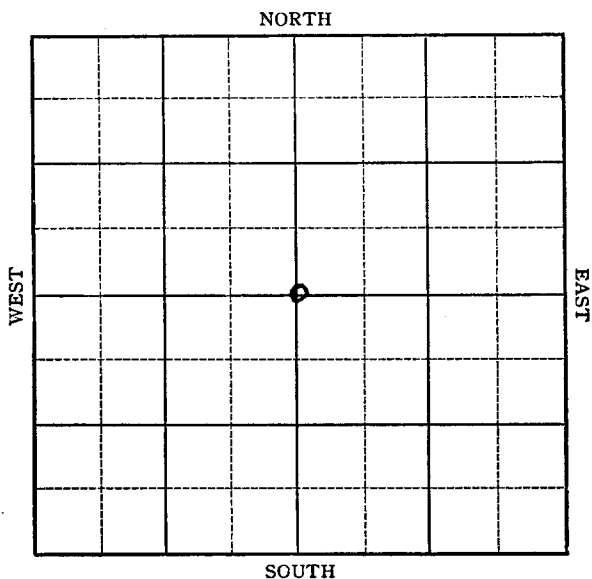

Sec. 20 Twp. 33- R. 37-W

Well No. #1, Barber King Farm
McKnabb et al Company


Hugoton
2640' Ft. from N. Line

Ft. from S. Line

2640' Ft. from E. Line

Ft. from W. Line

C Sec.

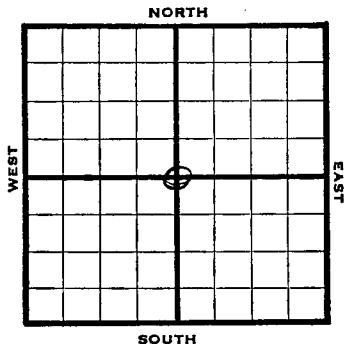

1946 Elev. 3123' REPORT

9/11 Location
9/18 "
9/24 "
10/1 "
10/8 "
10/15 "
10/22 RUR
10/29 10" @ 591'
Drlg 2472'
11/6 7" @ 2545-85 TD, RUST
1/12 " " "
1/20 " " "
1/27 TD 2762'
2/3 "
2/10 17000 acid
2/17 "

1947
1/2 17000 acid
1/8 7" @ 2545'
TD 2762'
17000 Acid
1,495,000 Gas
391# RPR

COMPLETED

Kans Pool Name HugotonMap No. _____ Sec. 20 Twp. 33 R. 37WWell No. 1 BarberMcKnabb Etal. CompanyFIRST REPORT Contractor

C Sec.


SECTION PLAT

2640 Ft. from N. Line

_____ Ft. from S. Line

2640 Ft. from E. Line

_____ Ft. from W. Line

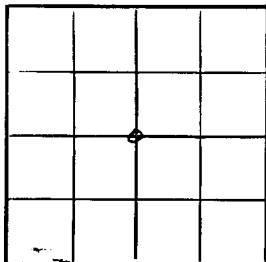Stevens CountyLocation X

Rig up _____

Drilling and Remarks:

RECORD

Cased _____ in, _____ ft.

Sand _____

Gas _____

Oil _____

Total Depth _____

PRODUCTION

1st 24 hrs. Nat. _____

1st 24 hrs. after shot _____

Gas _____ Cu. Ft.

Dry Hole _____

Abandoned _____

Date

SEP 11 1946 19

S. J. LEWIS

Scout

Form 26 200 Bks. 10-46 Perol
Kansas

Map No. _____ Sec. 20 Twp. 33 R. 37W

Well No. 1 King

McKnabb et al. Company

CORRECTION

Contractor

C Sec.


SECTION PLAT

2640 Ft. from N. Line

_____ Ft. from S. Line

2640 Ft. from E. Line

_____ Ft. from W. Line

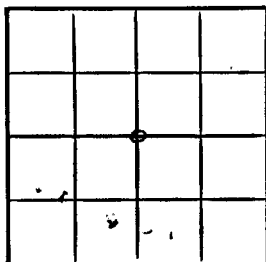

Stevens County

Location _____

Rig up _____

Drilling and Remarks:

Reported as

#1 Barber

RECORD

Cased _____ in., _____ ft.

Sand _____

Gas _____

Oil _____

Total Depth _____

PRODUCTION

1st 24 hrs. Nat. _____

1st 24 hrs. after shot _____

Gas _____ Cu. Ft.

Dry Hole _____

Abandoned _____

Date

OCT 9 1946

19

S. J. LEWIS

Scout

Map No. _____ Sec. 20 Twp. 33 R. 37W

Well No. 1 King

McKnabb Etal. Company

COMPLETE

C Sec. Contractor

E13128


SECTION PLAT

2640 Ft. from N. Line

Ft. from S. Line

2640 Ft. from E. Line

Ft. from W. Line

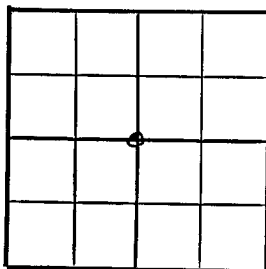

Stevens County

Location

RECORD

Cased _____ in. _____ ft.

Sand _____

Gas _____

Oil _____

Total Depth 2762

PRODUCTION

1st 24 hrs. Nat. _____

1st 24 hrs. after shot _____

Gas _____ Cu. Ft.

Dry Hole _____

Abandoned _____

Rig up

Drilling and _____

7" 82545

17000 Paid

1,495,000 Gas

Date

JAN 8 1947 19

S. J. LEWIS Scout