


Section 20 Township 33 Range 30W

Well No. #1 Bruno Meyer

Company Columbian Fuel Company

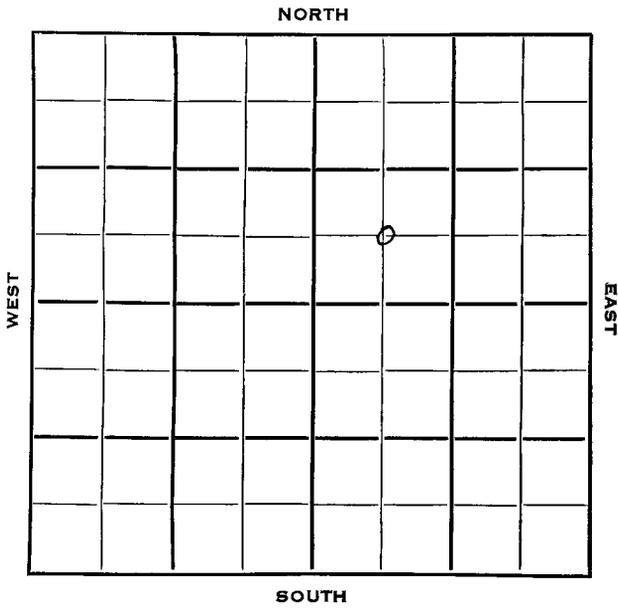

Meade

KANSAS ✓

Sec. 20 Twp. 33 R. 30W

Well No. #1 Bruno Meyer Farm

Columbian Fuel Company

Miss - Test ~~XXXXXXXXXX~~

Wildcat


Ft. from N. Line

660 Ft. from S. Line

660 Ft. from E. Line

Ft. from W. Line

C SW NE

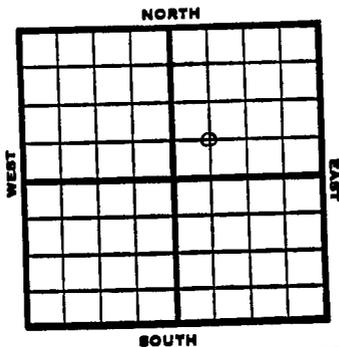

1953 Elev. 2717' REPORT

3/4 Location

3/12 "

3/19 13" @ 624  
8" @ 2627'

3/26 DST 3046-3126, 1½ hr, 140' fresh wtr  
630#

DST 3161-86, 1½ hr, 65' M  
Drlg. 3780'

4/2 Hol 2565, Her 2620, Kr 2685, Win

2730, Up Ft 2790, Low Ft 2870  
DST 4502-12 1½ Hr. 50' SO&GCM  
18' VSO & GCSW 1050#

DST 4577-89 1 Hr.  
770' SW 10' M 1365#  
Drlg 4800'

4/9 DST 4998-5010, 1 hr., 10' OCM&W,  
250' SW, 10' M, 1420#

DST 5131-60, 1½ hrs., 180' M&SW  
1485#  
Drlg. 5598'

4/16 Drlg.

4/23 5" Set.

4/30 N.R.

5/7 NR  
5/21 "

OVER


County Meade State Kansas

Sec. 20 (Blk. Twp.) 33 (Sur. Rge.) 30W Map No.

Operator Columbian Fuel

Well No. 1 Farm Bruno Meyer

Elev. \_\_\_\_\_ Location C SW NE

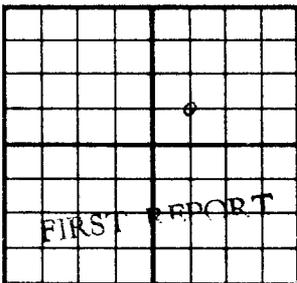

660 Ft. From S Line NE

660 Ft. From E Line Quarter

Ist. Report MAR 4 1950

Completion \_\_\_\_\_

Remarks Miss. test

Spudding Date \_\_\_\_\_

Drlg. Data Wildcat

Location



Drig. Data

1 3/4 hr.	Rec. 20' mud	0'	DST 5709-37
open 2 hr.	Rec. 35' h. h. gcm	750'	
Chester 5698	DST 6120-56	open 1 hr.	
Rec. 30' c	gcm 180' ocs	1405'	
DST 6001-33	gcm 1750'	vsgcm	
2250'	DST 6110-33	Rec.	
20' so & gc	TD 6156	5'	5775
CC to 5741	36/ 5710-16	FU 770' wtr.	8 h
8/ 2 boph	PE 5707	8/ 5704-05	
2 boph	CC to 5741	52/ 5693-5700	
3 boph	500 A	3 boph	Comp. 138 bopd