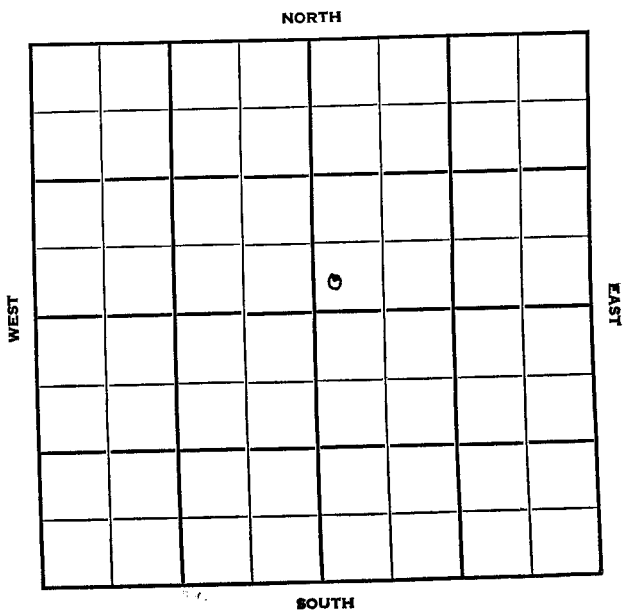


Section 20 Township 33 Range 33 WWell No. #1 MorganCompany Penhandle Eastern

Seward

KANSAS

SEC.	TWP.	R.
20	33	33W

WELL NO.

#1 Morgan

FARM

COMPANY

Panhandle Eastern

CONTRACTOR

Kuhn Drlg.

Hugoton

2440'

Ft. from N. Line


Ft. from S. Line

2440'

Ft. from E. Line

Ft. from W. Line

SW SW NE

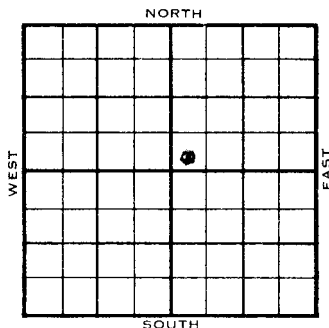

	ELEVATION	REPORT
1955	2850'	

8/3	Comm 7-27-55 8" @520/275 Drlg. 2195	Permian FIRST REPORT
1-16	8 5/8" @ 570/270 5 1/2" @ 2742/150 30/ 2670-75, 1000 A, 1,000 mcfg, 15 gw 52/ 2645-57, 1000 A, 3000 A, 2,366 mcf SP 2641 perf/ 2628-38, 2610-20, 2600-1 2586-94, 1000 A, frac CO to 2660 Comp. 1,322 mcfgpd 383# Herr. 2575 Minf 2701 TD 2745'	

COMPLETED

County Seward Elev. 2850Sec. 20 Twp. 3 3 Rge. 35WCompany Panhandle EasternFarm Name Morgan No. 1

TOPS	DEPTH	LOG	DATUM	Loc. in Sec.
Anh.				SW SW NE
TP.				
H.				2440' NL
Tr.				2440' EL
Dg.				
Bl.				
L.				
K.C.				Geol.
B.K.C.				Contr.
Ce.				Kuhn Drlg.
C.				Pool
M.				Hugoton
M.				
K.				
Mz.				
Me.				
V.				
S.				
S.				
A.				
R.				
Pe.				
G.				
T.D.				

Loc. in Sec.

SW SW NE

2440' NL

2440' EL

Geol.

Contr.

Kuhn Drlg.

Pool

Hugoton

FIRST REPORT	
0	
AUG 3 '55	

Date Comm. 7-27-55

Permian test

8" @ 520/275 drlg. 2195

35

County Seward Elev. 2850
 Sec. 20 Twp. 33 Rge. 33W
 Company Panhandle Eastern
 Farm Name Morgan No. 1

TOPS	DEPTH	LOG	DATUM	Loc. in Sec.
Anh.				
Tp.				SW SW NE
H. <u>err</u>		<u>2575</u>		
Tr. <u>Wing</u>		<u>2701</u>		2440' NL
Dg.				
Bl.				2440' EL
L.				
K.C.				Geol.
B.K.C.				Contr.
Ce.				Kuhn Drllg.
C.				
M.				Pool
M.				Huron
K.				
Mz.				
Me.				
V.				
S.				
S.				
A.				
R.				
Pe.				
G.				
TD	<u>2745</u>			COMPLETE

Date Comm. 7-27-55 NOV 16 1955

8" @ 520/275 8 5/8" @ 570/270

5 1/2" @ 2742/150 30/ 2670-75 1000 A

1,000 mcfg 15 gvph 52/ 2645-57

1000 A 3000 A 2,366 mcfg SP 2641

perf/ 2628-38 2610-20 2600-10

2586-94 1000 A frac CO to 2660

Comp. 1,322 mcfgpd 383#