


Map No. 5 Sec. 20 Twp. 33 R. 33ⁿ
 Well No. #1 Seely Farm _____
Seward & Co Sps Company

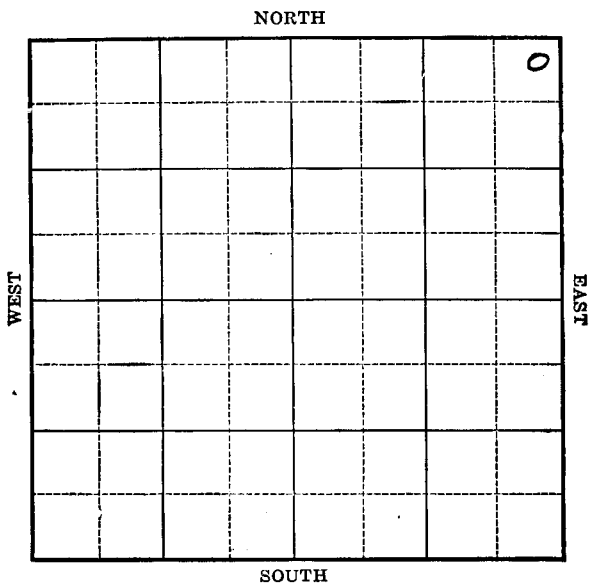

Location _____

Drilling Remarks:

Rig Up _____

Drilling Remarks:

RECORD

Cased _____ in. _____ ft.

Sand _____

Gas _____

Oil _____

Total Depth _____

PRODUCTION

1st 24 hrs. Nat. _____

1st 24 hrs. after shot _____

Gas _____ cu. ft.

Dry Hole _____

Abandoned _____

Map No. 5 Sec. 20 Twp. 33 R. 33

Well No. 1 Seely Farm


Seward & El Gas Company

200 Ft. from N. Line

_____ Ft. from S. Line

200 Ft. from E. Line

_____ Ft. from W. Line

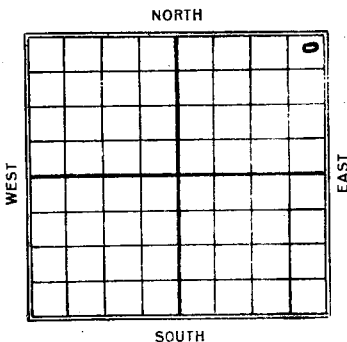

Beneas

Date

REPORT

1924	
4/9	Sh. 2600'
4/24	_____
11/22	_____
1925	
1/21	S.D. indef @ 2600
1/25	2727-49 277 Gas
6/12	2727-49 277 Gas
6/9	Sand 2727-49 277 Gas

Seward Co
 Map No. *No Map* Sec. *20* Twp. *33* R. *33W*

Well No. *# Seely*
Seward Oil & Gas Company

Contractor

FIRST REPORT

SECTION PLAT

200' Ft. from N. Line

----- Ft. from S. Line

200' Ft. from E. Line

----- Ft. from W. Line

			<i>0</i>

Location -----

Rig up -----

Drilling and Remarks:

O.D. 2600'

RECORD

Cased ----- in., ----- ft.

Sand -----

Gas -----

Oil -----

Total Depth -----

PRODUCTION

1st 24 hrs. Nat. -----

1st 24 hrs. after shot -----

Gas ----- Cu. Ft.

Dry Hole -----

Abandoned -----

Date
 APR 9 1924

M. A. BENEAR

192

Scout

MAP No. _____ SEC. 20 TWP. 33S R. 33WWELL No. 1 Seely

COMPANY _____

CONTRACTOR _____

SECTION PLAT

_____ FT. FROM N. LINE

_____ FT. FROM S. LINE

_____ FT. FROM E. LINE

_____ FT. FROM W. LINE

LOCATION _____

RIG UP _____

DRILLING AND REMARKS:

2727-2749
 2 miles ft. gas
 thru 6 5/8 csg

RECORD

CASED _____ IN. _____ FT.

SAND _____

GAS _____

OIL _____

TOTAL DEPTH 2764

PRODUCTION

1ST 24 HRS. NAT. _____

1ST 24 HRS. AFTER SHOT _____

GAS _____ CU. FT.

DRY HOLE ☒ABANDONED ☒

DATE

4/23 1925

SCOUT

Seward
 no map
 Map No. **KANSAS** Sec. 20 Twp. 33 R. 33W

Well No. 1 SealeySeward Oil & Gas Company

Contractor

SECTION PLAT

			0

200 Ft. from N. Line

----- Ft. from S. Line

200 Ft. from E. Line

----- Ft. from W. Line

COMPLETED

Location -----

Rig up -----

Drilling and Remarks:

Gas 272782749Est. 241. gas.

RECORD

Cased ----- in., ----- ft.

Sand -----

Gas -----

Oil -----

Total Depth -----

PRODUCTION

1st 24 hrs. Nat. -----

1st 24 hrs. after shot -----

Gas ----- Cu. Ft.

Dry Hole -----

Abandoned -----

Date

JUN 9 1926

192

S. J. LEWIS

Scout