

KANSAS

Seward

FORM 51 25M 3-49 PB 20

Section 20 Township 33 Range 34W

Well No. 1 Shuck


Company Panhandle Eastern

Hugoton

NORTH

WEST

EAST

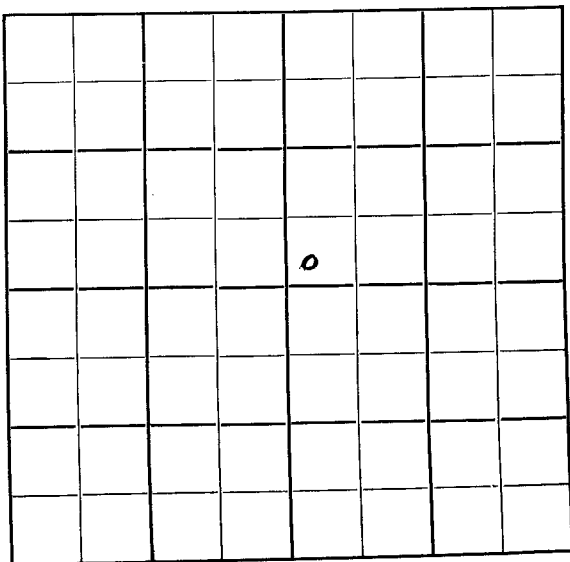

SOUTH

Seward

KANSAS 34W ✓
R.

Sec. 20 Twp. 33

Well No. #1 Shuck Farm

Panhandle Eastern

Company

Hugoton Pool


2500' Ft. from N. Line

Ft. from S. Line

2440' Ft. from E. Line

Ft. from W. Line

SW NE

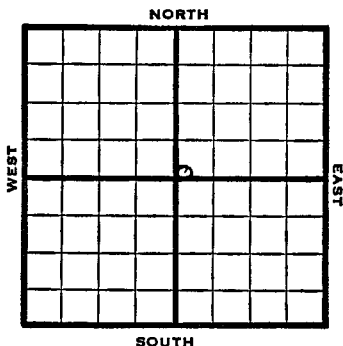

949 Elev. 2919' REPORT

9/21 10" @ 599'
Drlg. 1560'
9/28 TD 2609'
7" @ 2600'
10/5 "
10/12 161' of 5" Perf Liner @ 2745' TD
12000 acid
0/19 2000 acid
10/26 7" @ 2600'
161' of 5" Perf liner @ 2745
Acid 14,000
Gas 19,794,000
R Pr. 411#
TD 2745'

COMPLETED

Map No. _____ Sec. 20 Twp. 33 R. 34W

Well No. 1 Shuck

Panhandle Eastern Company

Contractor

SW NE


FIRST REPORT
SECTION PLAT

2500 Ft. from N. Line

_____ Ft. from S. Line

2440 Ft. from E. Line

_____ Ft. from W. Line

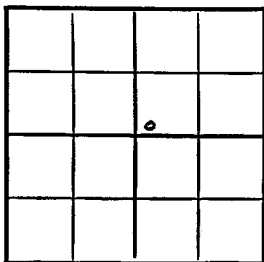

Seward County

Location _____

Rig up _____

Drilling and Remarks:

10" @ 599

drls. 1560

RECORD

Cased _____ in., _____ ft.

Sand _____

Gas _____

Oil _____

Total Depth _____

PRODUCTION

1st 24 hrs. Nat. _____

1st 24 hrs. after shot _____

Gas _____ Cu. Ft.

Dry Hole _____

Abandoned _____

Date

SEP 21 1949

19

S. J. LEALS Scout

Kansas

Hugoton Pool

Map No. _____ Sec. 20 Twp. 33 R. 34WWell No. 1 ShuckPanhandle Eastern

Company

ABANDONED

Contractor


SW NE

E 12919
SECTION PLAT2500 Ft. from N. Line

_____ Ft. from S. Line

2440 Ft. from E. Line

_____ Ft. from W. Line

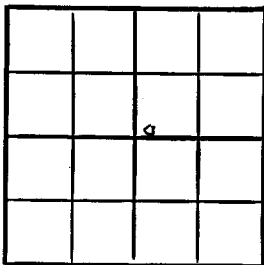Seward County

Location _____

Rig up _____

Drilling and Remarks:

7" @ 2600161' x 5" Pipe LineQ 274514000 cu ft19,797,000 cu ft4 1/2" x 1/2"

RECORD

Cased _____ in., _____ ft.

Sand _____

Gas _____

Oil _____

Total Depth 2745

PRODUCTION

1st 24 hrs. Nat. _____

1st 24 hrs. after shot _____

Gas _____ Cu. Ft.

Dry Hole _____

Abandoned _____

Date

OCT 23 1949

19

S. J. LEWIS

Scout